

P44
6-63

WATER WELL DRILLERS LOG

CODED

Date: June, 1963, Driller: David Benny County Yazoo
(Name)

(1) Owner of Land: E. H. Wade
(Name)

Delta City, Miss.
(Address)

(2) Location: SW 1/4, SW 1/4, Sec. 3 T15 R16,
Hwy 12 E

2 miles East, of Hollandale
(distance) (direction) (Nearest Town)

(3) Topography: Flat
(Hilly) (Flat) (Level)

(4) Purpose of Well: Domestic
(Domestic Irrigation
Municipal, Industrial, Other)

Description & Color of Materials Sand, Clay, Red Clay, Shell, etc.	Thick- ness Feet	Depth Feet
<u>Clay</u>		<u>12</u>
<u>Sand</u>	<u>62</u>	<u>80</u>
<u>Coarse sand & gravel</u>	<u>70</u>	<u>150</u>
<u>Clay</u>	<u>30</u>	<u>180</u>
<u>Shale - sandy</u>	<u>45</u>	<u>255</u>
<u>Sand</u>	<u>53</u>	<u>308</u>
<u>Sandy Shell</u>	<u>15</u>	<u>323</u>

Information upon completion of well:

(1) Diameter 2 inches.

(2) Total Depth 324 feet.

(3) Water Level 14'6" feet below top of ground.

(4) Cased to _____, Size _____

(5) Screen: Size 2, Length 10'

(6) Were any formations sealed against pollution?
_____ yes, _____ no.


If YES depth of formation _____

Why _____

Drillers Remarks: _____

CODED

~~Spec. info.~~
~~to books~~

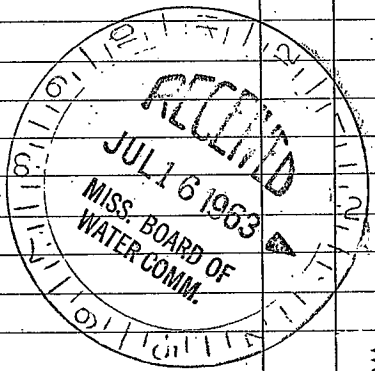

(Use Back Side)

Well No.

10

11

12

13