

Washington
 P 46
 3-67

WATER WELL DRILLERS LOG

Date: 3-9-67, 19 , Driller: Dyer Well & Irrigation County Washington

(Name)

- (1) Owner of Land: Greer Brothers
 (Name)
Hollandale, Miss.
 (Address)
- (2) Location: SE 1/4, NW 1/4, Sec. 13 T14R10W
5 miles S.E. of Hollandale
 (distance) (direction) (Nearest Town)
- (3) Topography: Flat
 (Hilly) (Flat) (Level)
- (4) Purpose of Well: Irrigation
 (Domestic Irrigation
 Municipal, Industrial, Other)

Description & Color of Materials Sand, Clay, Red Clay, Shell, etc.	Thick- ness Feet	Depth Feet
<u>0 - 13 Clay</u>		
<u>13 - 23 "</u>		
<u>23 - 33 #</u>		
<u>33 - 43 Fine Sand</u>		
<u>43 - 53 " "</u>		
<u>53 - 63 " "</u>		
<u>63 - 73 Coarse Sand & Gravel</u>		
<u>73 - 83 " "</u>		
<u>83 - 93 " "</u>		
<u>93 - 103 " "</u>		
<u>103 - 113 " "</u>		


Information upon completion of well:

- (1) Diameter 16 inches.
- (2) Total Depth 110 feet.
- (3) Water Level 21 feet below top of ground.
- (4) Cased to 70', Size 16 inch
- (5) Screen: Size 16inch Length 40'
- (6) Were any formations sealed against pollution?
 _____ yes, X no.

If YES depth of formation _____

Why _____

Drillers Remarks: None

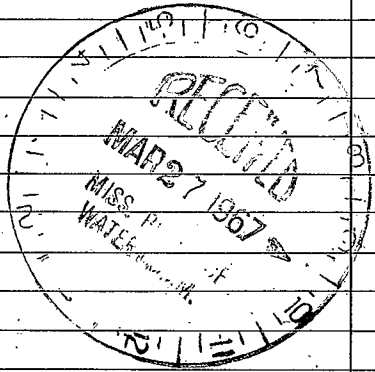

(Use Back Side)

Well No.

... ..

... ..

