

Washington
 P47
 5-68

MISSISSIPPI
 BOARD OF WATER COMMISSIONERS
 416 North State Street
 Jackson, Mississippi 39201

5/29/68
 C 2642

WATER WELL DRILLERS LOG

CODED

May 8, 19 68 Layne-Central Company Washington
 date well completed firm name county well located

LANDOWNER: Thomas Hollingsworth
 & Co.

| Description of formations encountered | from | to |
|---------------------------------------|------|-----|
| Clay | 0 | 14 |
| Coarse sand | 14 | 37 |
| Coarse sand, pea gravel | 37 | 50 |
| Coarse sand, pea gravel & big gravel | 50 | 94 |
| Boulders | 94 | 108 |

Hollandale, Mississippi
 (mailing address)

WELL LOCATION: NE 1/4 & NW 1/4
 sec. 27 T. 15 N R. 6 E
 S
 5 miles SE of Hollandale
 (distance) (direction) (nearest town)

WELL PURPOSE: Irrigation
 (home, irrigation, municipal, industrial)


- WELL COMPLETION DATA:
- (1) diameter (inches) 16
 - (2) total depth (feet) 108
 - (3) static water level (feet) ~~below~~ above top of ground.
 - (4) casing steel, 58' (material) (depth)
 16" (size) if telescope see back.
 - (5) screen 50' (length), 108' (depth to top)
 16" (size), Armco (material)
 - (6) pump 50 (HP), 2000 (yield gpm)
 engine (type power)
 - (7) electric log no (yes or no)
 (organization running log)
 - (8) how well bottom plugged plate

DRILLERS REMARKS:

MISSISSIPPI
 BOARD OF
 WATER COMMISSIONERS

If well telescopes please sketch and show depths.

GROUND LEVEL

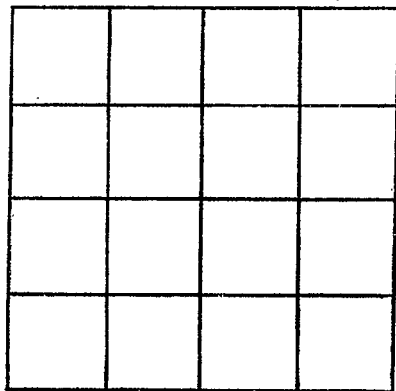

SECTION _____

Please indicate well location X.

ADDITIONAL INFORMATION

If more than one screen,
show locations of each on sketch.