

P 49
3-61

WATER WELL DRILLERS LOG

R
Washingt

Date: MAR., 19 61, Driller: BUTANE GAS CO OF WOOD County: DEFORE CODED

(Name)

(1) Owner of Land: W.M. KLINIK SCALES
(Name)
HOLLANDALE, MISS.
(Address)

(2) Location: NW 1/4, SE 1/4, Sec. 18 16N 5W
T R
8 miles SE of HOLLANDALE
(distance) (direction) (Nearest Town)

(3) Topography: FLAT
(Hilly) (Flat) (Level)

(4) Purpose of Well: IRRIGATION
(Domestic Irrigation
Municipal, Industrial, Other)

Description & Color of Materials Sand, Clay, Red Clay, Shell, etc.	Thick- ness Feet	Depth Feet
CLAY	21	21
QUICK SAND	15	36
COARSE SAND	18	54
COARSE SAND PER ROCK	13	67
FINE SAND	6	73
STREAKED SAND + P. ROCK	12	85
ROCK + PER ROCK	25	110

Information upon completion of well:

(1) Diameter 16 inches.

(2) Total Depth 110 feet.

(3) Water Level 15 feet below top of ground.

(4) Cased to 62', Size 16"

(5) Screen: Size 12", Length 48'


(6) Were any formations sealed against pollution?
_____ yes, X no.

Inst. inf
to locate

If YES depth of formation _____

Why _____

Drillers Remarks: _____

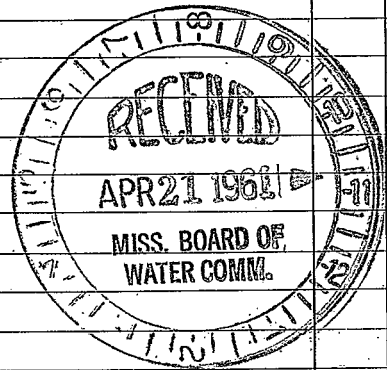

(Use Back Side)

Well No.

[The page contains extremely faint and illegible text, likely bleed-through from the reverse side of the document. No specific words or structures are discernible.]