

WASH.

CODED?

P52

WATER WELL DRILLERS LOG

7-26-60

Date: 7-26, 1960, Driller: Layne Central Co. County Washington
Cleveland, Miss.

(1) Owner of Land: George Stock

(Name)

Hollandale, Mississippi

(Address)

(2) Location: 1/4, 1/4, Sec. 31 T R

2 miles E. of Percy
(distance) (direction) (Nearest Town)

(3) Topography: X
(Hilly) (Flat) (Level)

(4) Purpose of Well: Irrigation
(Domestic Irrigation, Municipal, Industrial, Other)

Information upon completion of well:

- (1) Diameter 16" inches.
- (2) Total Depth 111' feet.
- (3) Water Level 18'-10" feet below top of ground.
- (4) Cased to 61', Size 16"
- (5) Screen: Size 16", Length 50'
- (6) Were any formations sealed against pollution?
yes, X no.

If YES depth of formation

Why

Drillers Remarks:

Description & Color of Materials
Sand, Clay, Red Clay, Shell, etc.


Thick-
ness
Feet

Depth
Feet

Sandy clay	12	12
Blue clay	26	38
Coarse sand	34	72
Medium sand	10	82
Coarse sand	10	92
Gravel	19	111
Rock		111

CODED

Insert info.
to locate

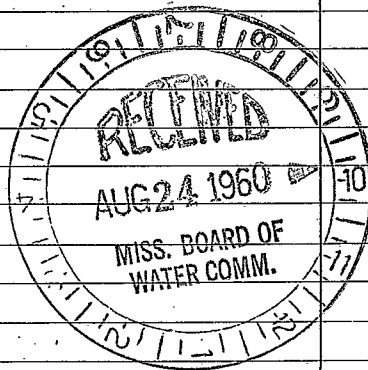

(Use Back Side)

Well No.

