

WASH.

P54

7-31-60

WATER WELL DRILLERS LOG

Q-7
CODEDDate: 7-31, 1960, Driller: Layne-Central Co. County Washington
Cleveland, Miss.

(1) Owner of Land: Charles Burnett

(Name)
Hollandale, Mississippi

(Address)

(2) Location: $\frac{1}{4}$, $\frac{1}{4}$, Sec. 26, T. 60 N., R. 12 W.8 miles S. E. of Hollandale
(distance) (direction) (Nearest Town)(3) Topography: X
(Hilly) (Flat) (Level)

(4) Purpose of Well: Irrigation

(Domestic Irrigation -
Municipal, Industrial, Other)

Information upon completion of well:

(1) Diameter 16" inches.

(2) Total Depth 112 feet.

(3) Water Level 20'-3" feet below top of ground.

(4) Cased to 62', Size 16"

(5) Screen: Size 16", Length 50'

(6) Were any formations sealed against pollution?

yes, X no.

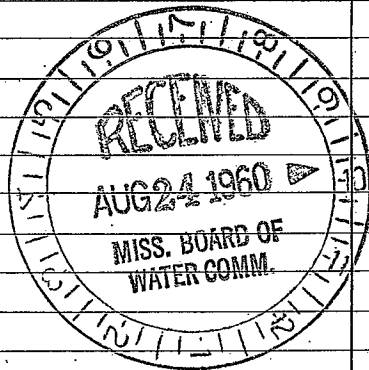
If YES depth of formation

Why

Drillers Remarks:

Description & Color of Materials Sand, Clay, Red Clay, Shell, etc.	Thick- ness Feet	Depth Feet
Clay	45	45
C. sand & pea gravel	27	72
C. sand & gravel	40	112

CODED

Inuff. info.
to locate

(Use Back Side)

Well No.

