

P 56
9-28-65

CODED

WATER WELL DRILLERS LOG

Date: 9/28, 1965, Driller: Barley Drilling Co County: Washington
(Name)

(1) Owner of Land: J H Collier
(Name)
Hollandale
(Address)
15N
(2) Location: 1/4, 1/4, Sec. 23 15N 6W T. R.
4 miles SE of Hollandale
(distance) (direction) (Nearest Town)
(3) Topography: Flat
(Hilly) (Flat) (Level)
(4) Purpose of Well: Domestic
(Domestic Irrigation
Municipal, Industrial, Other)

Description & Color of Materials - Sand, Clay, Red Clay, Shell, etc.	Thick- ness Feet	Depth Feet
Clay		10
Sand		110
Gravel		170
Mud		380
Sand		390
Mud		450
Sand + Mud		570
Mud		640
Sand + Mud		680
Mud		700
Sand + Mud		725
Mud		870
Sand		905


Information upon completion of well:

(1) Diameter 4x3x2 1/2 inches.
(2) Total Depth 905 feet.
(3) Water Level 23 feet below top of ground.
(4) Cased to all way, Size 4x3x2 1/2
(5) Screen: Size 2 1/2, Length 30 ft
(6) Were any formations sealed against pollution?
no

CODED

If YES depth of formation _____
Why _____
Drillers Remarks: _____

Insuff. info. to locate

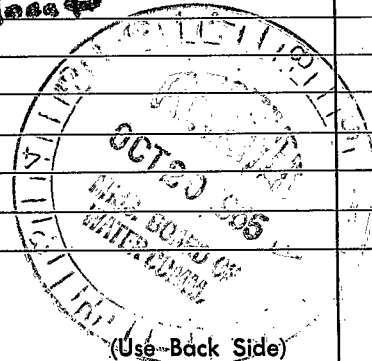

Well No.

