

P 58

8-20-62

WATER WELL DRILLERS LOG

CODED

Date: 8/20, 1962, Driller: Bailey Drlg Co. County: Washington
 (Name)

(1) Owner of Land: D. B. Tucker
 (Name)
Hollandale, Miss.
 (Address)
15 N 6 W
 (2) Location: 1/4, 1/4, Sec. 13 T. R.
4 miles east, of Hollandale
 (distance) (direction) (Nearest Town)
 (3) Topography: Flat
 (Hilly) (Flat) (Level)
 (4) Purpose of Well: Domestic
 (Domestic Irrigation, Municipal, Industrial, Other)


Description & Color of Materials Sand, Clay, Red Clay, Shell, etc.	Thick- ness Feet	Depth Feet
Clay	16	16
Sand		70
Gravel		128
Mud		225
Sand		292
Mud		298
Sand		357
Mud		460
Sand + mud		470
Mud		818
Rock		818 1/2
Mud		841
Fine sand		855
Mud		886
Rock		887 1/2
Sand		902
Mud + Sand		912
Sand		926
Mud + Sand		931
Fine Sand		947
Mud + Sand		951
Sand		964
Hard mud		974
fine sand		985
Sand		1007

Information upon completion of well:

(1) Diameter 2 inches.
 (2) Total Depth 1007 feet.
 (3) Water Level 3 feet above ground.
 (4) Cased to all way. Size 2.
 (5) Screen: Size 2, Length 10 ft.
 (6) Were any formations sealed against pollution?
yes, no.

If YES depth of formation _____
 Why _____
 Drillers Remarks: _____

CODED

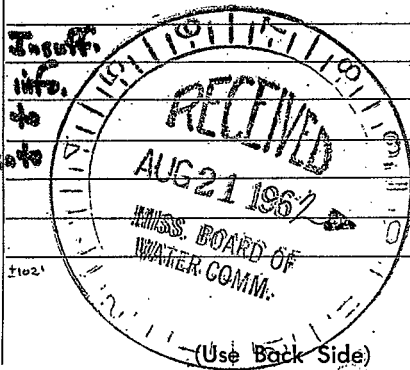

Well No.

1944

1945

1946

1973