

WASH.

MISSISSIPPI BOARD OF WATER COMMISSIONERS

CODED

P 59

8-20-62

WATER WELL DRILLERS LOG

Date: 8/20, 1962, Driller: Bailey Drilling Co. County Washington  
(Name)

(1) Owner of Land: W E Neely  
(Name)  
Hollandale, Miss.  
(Address)

(2) Location: 1/4, 1/4, Sec. 3 T. R  
15N 6W  
4 miles east, of Hollandale  
(distance) (direction) (Nearest Town)

(3) Topography: Flat  
(Hilly) (Flat) (Level)

(4) Purpose of Well: Domestic  
(Domestic Irrigation  
Municipal, Industrial, Other)

Description & Color of Materials Sand, Clay, Red Clay, Shell, etc.	Thick- ness Feet	Depth Feet
<u>Clay</u>	<u>18</u>	<u>18</u>
<u>Sand</u>	<u>95</u>	<u>113</u>
<u>Gravel</u>	<u>20</u>	<u>133</u>
<u>Mud</u>	<u>113</u>	<u>246</u>
<u>Rock</u>	<u>1</u>	<u>247</u>
<u>Mud</u>	<u>53</u>	<u>300</u>
<u>Sand</u>	<u>75</u>	<u>375</u>

Information upon completion of well:

(1) Diameter 3 X 2 inches.

(2) Total Depth 375 feet.

(3) Water Level 13 1/2 feet below top of ground.

(4) Cased to all way, Size 3 X 2.

(5) Screen: Size 2, Length 10 ft.

(6) Were any formations sealed against pollution?  
X yes, X no.


CODED

Insuff. info.  
to locate

If YES, depth of formation \_\_\_\_\_

Why \_\_\_\_\_

Drillers Remarks: \_\_\_\_\_

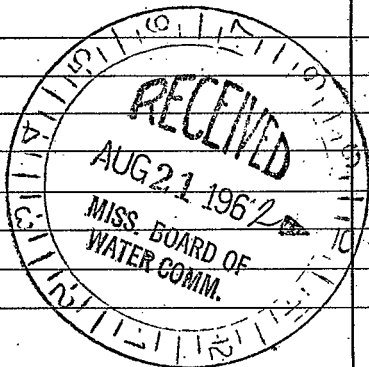

(Use Back Side)

Well No.

[The text in this block is extremely faint and illegible. It appears to be a multi-paragraph document, possibly a letter or a report, with several lines of text visible but not readable.]