

Washington
P 68
3-69

MISSISSIPPI
BOARD OF WATER COMMISSIONERS **CODED**
416 North State Street
Jackson, Mississippi 39201

WATER WELL DRILLERS LOG

3/26 1969 date well completed
Bailey Drly. Co. firm name
Washington county well located

LANDOWNER: D.M. Barefield
Hollandale
Miss.
(mailing address)

description of formations encountered	from	to
Clay	0	25
Sand	25	65
Gravel	65	80
Mud	80	250
Sand + Mud	250	325
Mud	325	353
Sand	353	378

WELL LOCATION:
sec. 11 T. 15 N. R. 6 E
3 miles E of Hollandale
(distance) (direction) (nearest town)

WELL PURPOSE: home
(home, irrigation, municipal, industrial)

- WELL COMPLETION DATA:
- (1) diameter (inches) 3 X 2
 - (2) total depth (feet) 378
 - (3) static water level (feet) 30 below/above top of ground.
 - (4) casing steel (material) (depth)
 - 3 X 2 if telescope see back. (size)
 - (5) screen 20 ft. 358 (length) (depth to top)
2" Stainless Steel (size) (material)
 - (6) pump 1 10 (HP) (yield gpm)
elec (type power)
 - (7) electric log no (yes or no)

CODED

MADE BY 1969

(organization running log)

(8) how well bottom plugged
back pressure valve

DRILLERS REMARKS:


If well telescopes please sketch and show depths.

GROUND LEVEL

1051 3"

5124 1"

207 1 1/2"

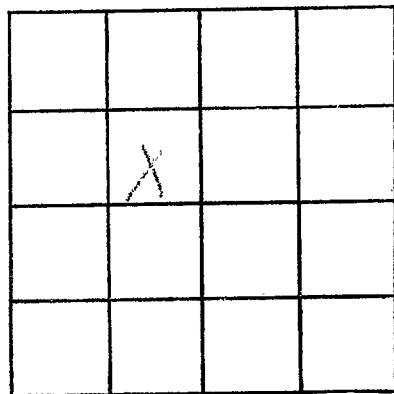

SECTION 11

Please indicate well location X.

ADDITIONAL INFORMATION

If more than one screen, show locations of each on sketch.