

Washington  
 P.O.  
 5-26-69

MISSISSIPPI  
 BOARD OF WATER COMMISSIONERS  
 416 North State Street  
 Jackson, Mississippi 39201

CODED  
 CODED

WATER WELL DRILLERS LOG

5-26 date well completed      1968 Dyer Water Sec. WASD. firm name      county well located

LANDOWNER:  
 Billy Harris  
 R.R. HOLLANDALE  
 (mailing address)

| description of formations encountered | from | to   |
|---------------------------------------|------|------|
| Clay                                  | Top  | 12'  |
| Sand                                  | 12'  | 20'  |
| Sand & gravel                         | 20'  | 160' |
| Clay                                  | 160' | 270' |
| Sand                                  | 270' | 360' |

WELL LOCATION:  
 sec. 1 T. 15 N R. 6 W  
 4 miles EAST of HOLLANDALE  
 (distance) (direction) (nearest town)

WELL PURPOSE: HOME  
 (home, irrigation, municipal, industrial)

- WELL COMPLETION DATA:
- diameter (inches) 4 1/2"
  - total depth (feet) 360'
  - static water level (feet) 12' below top of ground
  - casing GALV. TO 340 FT (material) (depth)  
 If telescope see back.  
 (size)
  - screen 20 FT 340 FT. (length) (depth to top)  
 2" STAINLESS STEEL (size) (material)
  - pump 1 (HP) 30 (yield gpm)  
 ELEC. (type power)
  - electric log No (yes or no)  
 (organization running log)
  - how well bottom plugged DP VALVE


DRILLERS REMARKS:

SET 30  
 MISS BD OF

If well telescopes please sketch and show depths.

GROUND LEVEL

4" DIRECT CONNECTED  
TO 2" WITH 4X2  
SWAGE WIPPLE  
2" SCREEN DIRECT  
CONNECTED.

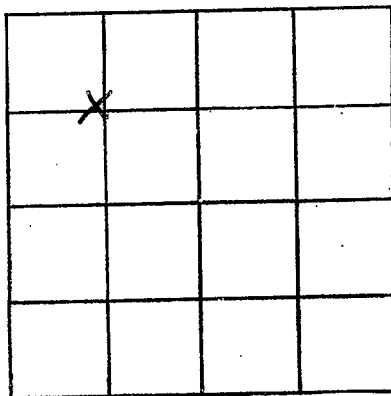

SECTION 1

Please indicate well location X.

ADDITIONAL INFORMATION

If more than one screen,  
show locations of each on sketch.