

WASHINGTON
 P65
 3-25-71

MISSISSIPPI
 BOARD OF WATER COMMISSIONERS
 416 North State Street
 Jackson, Mississippi 39201

CODED

WATER WELL DRILLERS LOG

DYER WELL & IRRIGATION SERVICE WASHINGTON

3/25/71 1971 date well completed firm name county well located

LANDOWNER:
 Bowen Bros
 DELTA CITY MISS.
 (mailing address)

description of formations encountered	from	to
	CLAY	0
SAND & CLAY	25	50
SAND & GRAVEL	50	110

WELL LOCATION:
 sec 35 T 15 N R 6 E
 3 miles No of DELTA CITY
 (distance) (direction) (nearest town)

WELL PURPOSE: IRR.
 (home, irrigation, municipal, industrial)

CODED

- WELL COMPLETION DATA:
- (1) diameter (inches) 16"
 - (2) total depth (feet) 110'
 - (3) static water level (feet) 18' below top of ground.
 - (4) casing BLK INO 70' (material) (depth)
 16" (size) if telescope see back.
 - (5) screen 40' 70' (length) (depth to top)
 16" BLK INO (size) (material)
 - (6) pump 60 3100 (HP) (yield gpm)
 DIESEL (type power)
 - (7) electric log NO (yes or no)
 - (organization running log)
 - (8) how well bottom plugged PLATE



MAY 3 - 1971

DRILLERS REMARKS:

MISS. Bd. of
 WATER COMMISSIONERS

If well telescopes please sketch and show depths.

GROUND LEVEL

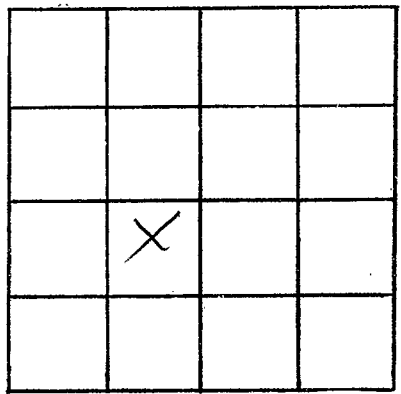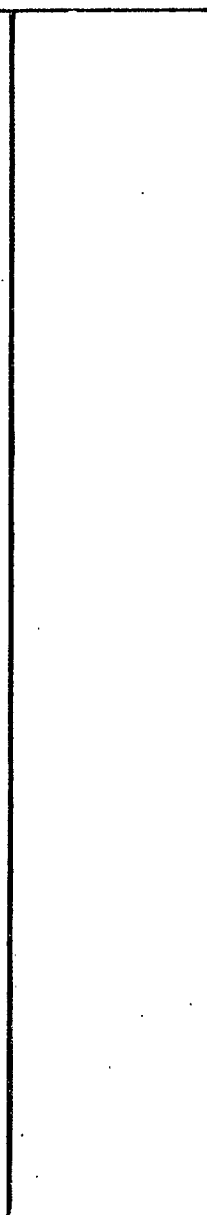

SECTION 35

Please indicate well location X.

ADDITIONAL INFORMATION

Lined area for additional information.

If more than one screen, show locations of each on sketch.