

WASHINGTON  
P66  
4-22-71

MISSISSIPPI  
BOARD OF WATER COMMISSIONERS  
416 North State Street  
Jackson, Mississippi 39201

**CODED**

WATER WELL DRILLERS LOG  
DYER WELL & IRRIGATION SERVICE

WASHINGTON  
county well located

4/22/71  
date well completed

firm name

LANDOWNER:  
DAVE JONES.  
R.R. ISOLA, MISS.  
(mailing address)

description of formations encountered	from	to
CLAY	0	10
FINE SAND	10	30
SAND & GRAVEL	30	60
FINE SAND	60	70
SAND & GRAVEL	70	110

WELL LOCATION:  
sec. 23 T. 15 N. R. 6 E. S. 5  
(distance) miles West of MURPHY (nearest town)

WELL PURPOSE: FISH  
(home, irrigation, municipal, industrial)

- WELL COMPLETION DATA:
- (1) diameter (inches) 16"
  - (2) total depth (feet) 110'
  - (3) static water level (feet) 12' below above top of ground.
  - (4) casing BUCKE 70'  
(material) (depth)  
16" (size) if telescope see back.
  - (5) screen 40' 70'  
(length) (depth to top)  
16" BUCKE INCO  
(size) (material)
  - (6) pump 50 2500  
(HP) (yield gpm)  
DIESEL  
(type power)
  - (7) electric log NO  
(yes or no)
  - (organization running log)
  - (8) how well bottom plugged PLATE

**CODED**


MAY 3 - 1971  
WLL

DRILLERS REMARKS:

MISS. Bd. of  
WATER COMMISSIONERS

If well telescopes please sketch and show depths.

GROUND LEVEL

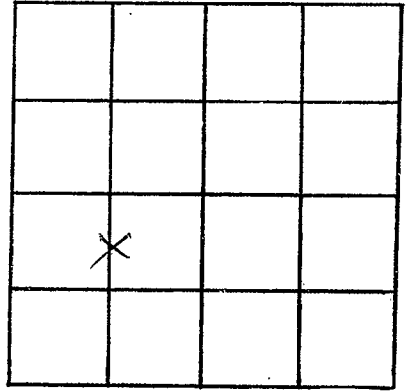

SECTION 23

Please indicate well location X.

ADDITIONAL INFORMATION

If more than one screen,  
show locations of each on sketch.