

WASHINGTON
P 69
4-15-72

MISSISSIPPI
BOARD OF WATER COMMISSIONERS
416 North State Street
Jackson, Mississippi 39201

CODED

WATER WELL DRILLERS LOG

4-15 1972 W. Schultz Drilling Co Washington
date well completed firm name county well located

LANDOWNER:

Deer Creek Camp
Hollandale Miss
(mailing address)

description of formations encountered

from to

Clay	0	21
Sand	21	148
Clay	148	201
Shale + Sand	201	262
Sand	262	390
Clay	390	403
Sand	403	444

WELL LOCATION:

sec. 7 T. 15 N. R. 6 E.
0 miles 0 of Hollandale
(distance) (direction) (nearest town)

WELL PURPOSE: Domestic
(home, irrigation, municipal, industrial)

WELL COMPLETION DATA:

- (1) diameter (inches) 4 x 2 1/2
- (2) total depth (feet) 430
- (3) static water level (feet) 27 below above top of ground.
- (4) casing Galv (material) (depth) (size) if telescope see back.
- (5) screen 30 (length) (depth to top) 2 1/2 (size) 316 stainless (material)
- (6) pump 10 (HP) 80 (yield gpm) Elc (type power)
- (7) electric log no (yes or no) (organization running log)
- (8) how well bottom plugged flush

CODED


APR 19 1972
MISS. BL. 05
WATER COMMISSIONERS

DRILLERS REMARKS:

If well telescopes please sketch and show depths.

GROUND LEVEL

30ft 223ft 126ft
2 1/2" screen 2 1/2" 4"
1 5/8" screen

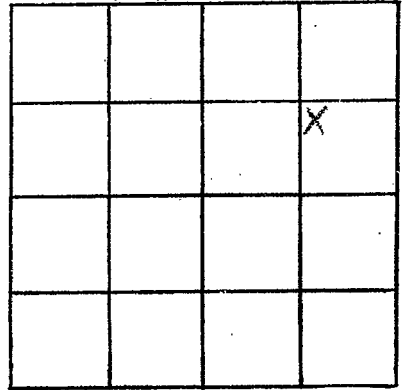

SECTION 7

Please indicate well location X.

ADDITIONAL INFORMATION

If more than one screen, show locations of each on sketch.