

WASH.  
P 71  
6-20-73

MISSISSIPPI  
BOARD OF WATER COMMISSIONERS  
416 North State Street  
Jackson, Mississippi 39201

CODED

WATER WELL DRILLERS LOG

6-20 1973 DYER WELL & IRRIGATION SERVICE WASHINGTON  
date well completed firm name county well located

LANDOWNER: Tom Bucher  
HOLLANDALE  
MISS.  
(mailing address)

description of formations encountered	from	to
	<u>Clay</u>	<u>0</u>
<u>Sand</u>	<u>23</u>	<u>50</u>
<u>Sand gravel</u>	<u>50</u>	<u>103</u>

WELL LOCATION:  
sec. 9 T. 15 N. R. 6 E.  
1 1/2 miles S.E. of HOLLANDALE  
(distance) (direction) (nearest town)

WELL PURPOSE: FRP  
(home, irrigation, municipal, industrial)

- WELL COMPLETION DATA:
- (1) diameter (inches) 16"
  - (2) total depth (feet) 103'
  - (3) static water level (feet) 20' below top of ground.
  - (4) casing BUC IR, 63'  
(material) (depth)  
16" if telescope see back.  
(size)
  - (5) screen 40', 63'  
(length) (depth to top)  
16", BUC IN GAT  
(size) (material)
  - (6) pump 30, 17.58  
(HP) (yield gpm)  
FLEC  
(type power)
  - (7) electric log NO  
(yes or no)
  - (organization running log)
  - (8) how well bottom plugged PLATE


CODED

DRILLERS REMARKS:

OCT 25 1973

If well telescopes please sketch and show depths.

GROUND LEVEL

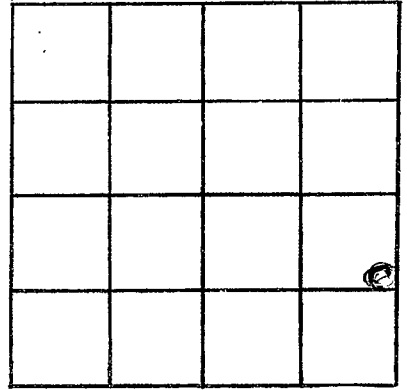

SECTION P

Please indicate well location X.

ADDITIONAL INFORMATION

If more than one screen,  
show locations of each on sketch.