

WASH.
P72
6-15-73

MISSISSIPPI
BOARD OF WATER COMMISSIONERS
416 North State Street
Jackson, Mississippi 39201

CODED

WATER WELL DRILLERS LOG

6-15 1973 DYER WELL & IRRIGATION SERVICE WASHINGTON
date well completed firm name county well located

LANDOWNER: Green's Dry & Shop
HOLLANDALE,
Miss.
(mailing address)

WELL LOCATION:
10 sec. T. 15 N. R. 6 E. W.
2 1/2 miles S. E. of HOLLANDALE
(distance) (direction) (nearest town)

WELL PURPOSE: IRR.
(home, irrigation, municipal, industrial)

WELL COMPLETION DATA:

- (1) diameter (inches) 16"
- (2) total depth (feet) 113'
- (3) static water level (feet) 19' below top of ground.
- (4) casing BUC IR. 73' (material) (depth)
16" (size) if telescope see back.
- (5) screen 40' 73' (length) (depth to top)
16" BUC IUGDT (size) (material)
- (6) pump 50 2500 (HP) (yield gpm)
DIESEL (type power)
- (7) electric log NO (yes or no)
(organization running log)
- (8) how well bottom plugged RATE

description of formations encountered	from to	
	feet	feet
Clay	0	20
fine sand	20	33
hard gravel	33	113

CODED


OCT 25 1973

DRILLERS REMARKS:

MISS. BD. OF
WATER COMM.

If well telescopes please sketch and show depths.

GROUND LEVEL

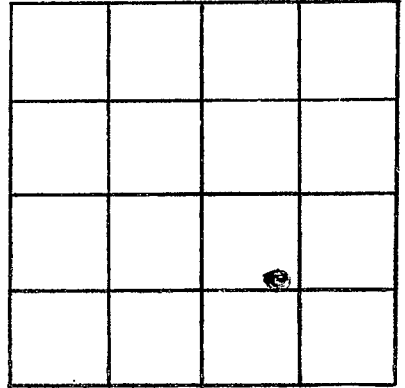

SECTION 10

Please indicate well location X.

ADDITIONAL INFORMATION

If more than one screen,
show locations of each on sketch.