

WASH.  
P 74  
8-8-74

MISSISSIPPI  
BOARD OF WATER COMMISSIONERS  
416 North State Street  
Jackson, Mississippi 39201 **CODED**

WATER WELL DRILLERS LOG

8-8 date well completed      74 OWENS P/b's Well Drilling Wash firm name      county well located

LANDOWNER:  
LOUIS KEITH  
HOLLANDALE MISS  
RT-2 BOX 15 (mailing address)  
WELL LOCATION:  
sec 23 T 15 (N) R 2 E  
S (W)  
5 1/2 miles EAST of HOLLANDALE  
(distance) (direction) (nearest town)

description of fomations encountered	from	to
top soil	0	16
Sand & gravel	16	205
clay	205	263
Sand	263	411

WELL PURPOSE:  
(home, irrigation, municipal, industrial)

- WELL COMPLETION DATA:
- (1) diameter (inches) 2" 411
  - (2) total depth (feet) 411
  - (3) static water level (feet) 16 below top of ground.
  - (4) casing Galv. 401  
(material) (depth)  
(size) if telescope see back.
  - (5) screen 10' 411'  
(length) (depth to top)  
2" S.S.  
(size) (material)
  - (6) pump 1 55  
(HP) (yield gpm)  
Elec.  
(type power)
  - (7) electric log NO  
(yes or no)  
(organization running log)
  - (8) how well bottom plugged S.B.

CODED


RECEIVED  
AUG 12 1974

DRILLERS REMARKS: Owens

MISS. BD. OF WATER COMM

If well  please  
sketch  depths.

GROUND LEVEL

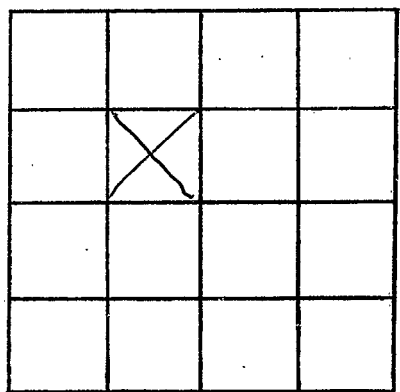

SECTION \_\_\_\_\_

Please indicate well location X.

ADDITIONAL INFORMATION

Lined area for additional information.

If more than one screen,  
show locations of each on sketch.