

WASHINGTON
P 77
5-27-77

MISSISSIPPI
BOARD OF WATER COMMISSIONERS
416 North State Street
Jackson, Mississippi 39201

CODED

WATER WELL DRILLERS LOG

5-27 19 77 Layne Central Co. Washington
date well completed firm name county well located

LANDOWNER:	description of formations encountered	from	to
Elmon Thomas	Clay	0	16
Hollandale, MS	Sand	16	35
(mailing address)	Med. Coarse Sand	35	42
	Coarse Sand	42	46
WELL LOCATION:	Sand & Clay Balls	46	53
sec. 3 T. 15 N R. 6 W	Fine Sand	53	59
3 miles E of Hollandale	Coarse Sand	59	65
(distance) (direction) (nearest town)	Coarse Sand & Pea Gravel	65	70
	Coarse Sand & gravel	70	83
WELL PURPOSE: Irrigation	Coarse Sand	83	95
(home, irrigation, municipal, industrial)	Coarse Sand & Gravel	95	112

WELL COMPLETION DATA:

(1) diameter (inches) 16"

(2) total depth (feet) 112'

(3) static water level (feet) 21 below top of ground.

(4) casing Steel 62' (material) (depth) 16" (size) if telescope see back.

(5) screen 50' 62' (length) (depth to top) 16" St. Steel (size) (material)

(6) pump 60 2500 (HP) (yield gpm) diesel (type power)

(7) electric log No (yes or no)

(organization running log)

(8) how well bottom plugged St. Plate

CODED


RECEIVED
SEP 10 1977

DRILLERS REMARKS:

MISS. BD. OF WATER COMMISSIONERS

If well telescopes please sketch and show depths.

GROUND LEVEL

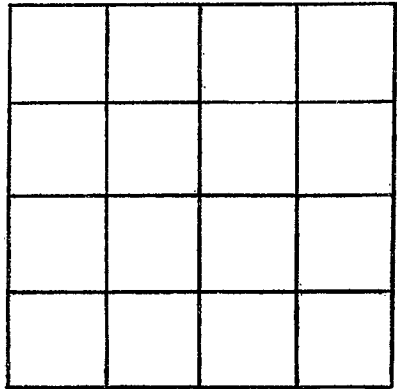

SECTION _____

Please indicate well location X.

ADDITIONAL INFORMATION

If more than one screen, show locations of each on sketch.