

CL-0610 WASH.

P 78

9-8-77

MISSISSIPPI BOARD OF WATER COMMISSIONERS
416 North State Street
Jackson, Mississippi 39201

WATER WELL DRILLERS LOG

CODED

9-8
date well completed

1977

Layne Central Co.
firm name

Washington
county well located

LANDOWNER:	description of formations encountered	from	to
MS. Cottonseed Products Co.			
Hollandale, MS	fine sand	22	36
(mailing address)	m. sand	36	42
WELL LOCATION:	c. sand	42	52
sec. 6 T. 15 N. R. 6 E.	c. sand & p. gravel	52	64
S. W.	m. sand	64	70
Hollandale	c. sand & p. gravel & gravel	70	112
(distance) miles (direction) of (nearest town)			
WELL PURPOSE: industrial (home, irrigation, municipal, industrial)			
WELL COMPLETION DATA:			
(1) diameter (inches) 12"			
(2) total depth (feet) 111'			
(3) static water level (feet) 23' below top of ground.			
(4) casing Steel 80' (material) (depth)			
12" (size) if telescope see back.			
(5) screen 30' 80' (length) (depth to top)			
10" St. Steel (size) (material)			
(6) pump 15 800 (HP) (yield gpm)			
electric (type power)			
(7) electric log No. (yes or no)			
(organization running log)			
(8) how well bottom plugged St. Plate			
DRILLERS REMARKS:			

CODED


RECEIVED

MAR 2 1978

MISS. BD. OF WATER COMMISSIONERS

If well telescopes please sketch and show depths.

GROUND LEVEL

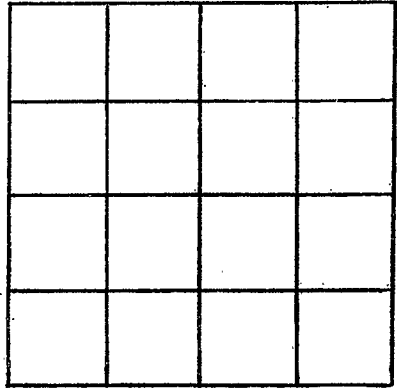

SECTION _____

Please indicate well location X.

ADDITIONAL INFORMATION

If more than one screen, show locations of each on sketch.