

WASHINGTON  
 CT-0778  
 P 79  
 3-1-78

MISSISSIPPI  
 BOARD OF WATER COMMISSIONERS  
 416 North State Street  
 Jackson, Mississippi 39201

CODED

WATER WELL DRILLERS LOG

3-1 1978 LAYNE CENTRAL CO. WASHINGTON  
 date well completed firm name county well located


LANDOWNER:	description of formations encountered	from	to
Bruton Farms Hollandale, MS			
(mailing address)	Fine Sand	52	55
WELL LOCATION:	Coarse Sand - Pea Gr.	55	75
sec. 32 T. 15 N R. 6 W	Gravel	75	117
(distance) miles (direction) of (nearest town)	Clay	117	
WELL PURPOSE: Irrigation			
(home, irrigation, municipal, industrial)			
WELL COMPLETION DATA:			
(1) diameter (inches) 16"			
(2) total depth (feet) 119'			
(3) static water level (feet) 21 below top of ground.			
(4) casing Steel 57' (material), (depth)			
16" (size) if telescope see back.			
(5) screen 52' 57' (length), (depth to top)			
12" St. Steel (size), (material)			
(6) pump 60 2500 (HP), (yield gpm)			
electric (type power)			
(7) electric log No (yes or no)			
(organization running log)			
(8) how well bottom plugged St. Plate			
DRILLERS REMARKS:			

CODED

RECEIVED  
 5/19/78

If well telescopes please sketch and show depths.

GROUND LEVEL

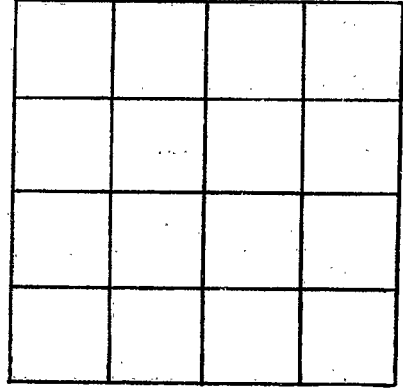

SECTION \_\_\_\_\_

Please indicate well location X.

ADDITIONAL INFORMATION

If more than one screen,  
show locations of each on sketch.