

WASH.

CL-0781 P81

4-2-78

MISSISSIPPI BOARD OF WATER COMMISSIONERS  
416 North State Street  
Jackson, Mississippi 39201

CODED

WATER WELL DRILLERS LOG

4-2 19 78  
date well completed

LAYNE CENTRAL CO.  
firm name

WASHINGTON  
county well located

LANDOWNER:

JAMES T. HOLLINGSWORTH

HOLLANDALE, MS  
(mailing address)

WELL LOCATION:

sec 9 T 15 N R 6 E  
3. miles SE of Hollandale  
(distance) (direction) (nearest town)

WELL PURPOSE: Irrigation  
(home, irrigation, municipal, industrial)

WELL COMPLETION DATA:

- (1) diameter (inches) 16"
- (2) total depth (feet) 114'
- (3) static water level (feet) 21' below top of ground.
- (4) casing steel, 64', (material) (depth)  
16" if telescope see back. (size)
- (5) screen 50', 64', (length) (depth to top)  
12", st. steel (size) (material)
- (6) pump 50 2400 (HP) (yield gpm)  
electric (type power)
- (7) electric log no (yes or no)  
(organization running log)
- (8) how well bottom plugged st. plate


description of formations encountered

from

to

clay	0	14
coarse sand	14	57
coarse sand & gravel	57	63
coarse sand	63	69
coarse sand & pea gravel	69	86
coarse sand & gravel	86	114

CODED

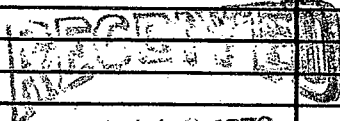


NOV 10 1978

DRILLERS REMARKS:

MISS. BD. OF WATER COMM

If well telescopes please  
sketch and show depths.

GROUND LEVEL

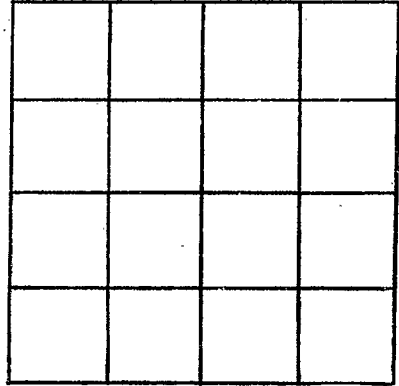

SECTION \_\_\_\_\_

Please indicate well location X.

ADDITIONAL INFORMATION

If more than one screen,  
show locations of each on sketch.