

WASHINGTON

CL-0778

P83

~~3-28-79~~

10-17-78

MISSISSIPPI BOARD OF WATER COMMISSIONERS
416 North State Street
Jackson, Mississippi 39201

CODED

WATER WELL DRILLERS LOG

10-17 date well completed

19 78

LAYNE CENTRAL CO.

firm name

WASHINGTON

county well located

LANDOWNER: Bruton Farms

Hollandale, MS

(mailing address)

WELL LOCATION:

sec. 34 T 15 N R 6 E
S W
5 miles SE of Hollandale
(distance) (direction) (nearest town)

WELL PURPOSE: Irrigation
(home, irrigation, municipal, industrial)

WELL COMPLETION DATA:

- (1) diameter (inches) 16"
- (2) total depth (feet) 117'
- (3) static water level (feet) 19' below
top of ground. above
- (4) casing steel 68'
(material) (depth)
16"
(size) if telescope see back.
- (5) screen 49' 68'
(length) (depth to top)
12" st. steel
(size) (material)
- (6) pump 60 2500
(HP) (yield gpm)
electric
(type power)
- (7) electric log no
(yes or no)

(organization running log)
- (8) how well bottom plugged St. Plate

description of formations encountered

from

to

clay	0	14
clay	14	22
clay	22	32
clay	32	42
clay	42	48
fine sand	48	52
coarse sand & pea grav.	52	62
" " " "	62	72
" " " "	72	82
" " " "	82	92
" " " "	92	102
" " " "	102	117

CODED

Miss. Board of Water Comm.


10-27-1978

DRILLERS REMARKS:

CODED

If well telescopes please sketch and show depths.

GROUND LEVEL

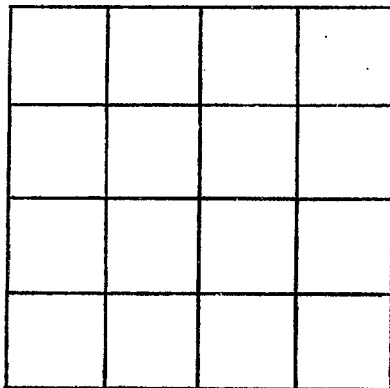

SECTION _____

Please indicate well location X.

ADDITIONAL INFORMATION

If more than one screen, show locations of each on sketch.