

WASHINGTON
 P84
 8-29-79

MISSISSIPPI
 BOARD OF WATER COMMISSIONERS
 416 North State Street
 Jackson, Mississippi 39201

CODED

WATER WELL DRILLERS LOG

8-29-'79 date well completed
 1979 Larry's Well Pump Co. firm name
 Washington Co. county well located

LANDOWNER: E.P. Thomas
 Hollandale Miss
 (mailing address)

description of formations encountered	from	to
clay	0	20
fine sand	20	50
coarse sand	50	174

WELL LOCATION:
 sec. 10 T 15 N R 6 E
 2 miles East of Hollandale
 (distance) (direction) (nearest town)

WELL PURPOSE: fish pond
 (home, irrigation, municipal, industrial)

CODED


- WELL COMPLETION DATA:
- (1) diameter (inches) 16"
 - (2) total depth (feet) 114
 - (3) static water level (feet) 22 below top of ground.
 - (4) casing steel 74' (material) (depth)
 - (5) screen 40 74' (length) (depth to top)
 - 16" steel (size) (material)
 - (6) pump 30 2000 (HP) (yield gpm)
 - D (type power)
 - (7) electric log (yes or no)
 - (organization running log)
 - (8) how well bottom plugged steel

Rec'd 9-15-79
 [Signature]

DRILLERS REMARKS:

If well telescopes please sketch and show depths.

GROUND LEVEL

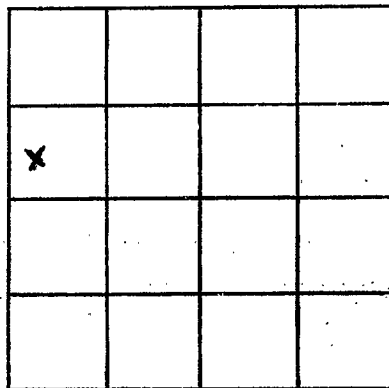

SECTION 10

Please indicate well location X.

ADDITIONAL INFORMATION

If more than one screen,
show locations of each on sketch.