

P-87
WASHINGTON
7-10-80

MISSISSIPPI
BOARD OF WATER COMMISSIONERS
416 North State Street
Jackson, Mississippi 39201

CODED

WATER WELL DRILLERS LOG

10 July 1980 date well completed Lambert Drilling firm name Wash county well located

LANDOWNER:	description of formations encountered	from	to
Hamp, Colliery			
Hollandale, Miss. (mailing address)	Mixed	0	5
WELL LOCATION:	Clay	5	45
sec 18 T 16 N R 6 E 4 miles S of Hollandale (distance) (direction) (nearest town)	Sand & gravel	45	142
WELL PURPOSE: none (home, irrigation, municipal, industrial)	Clay	142	210
WELL COMPLETION DATA:	Clay st sand	210	405
(1) diameter (inches) 4x2	Sand, eight	405	510
(2) total depth (feet) 670	Sand, eight	510	630
(3) static water level (feet) 38 below top of ground.	Sand good	630	670
(4) casing PVC 650 (material) (depth) 4x2 If telescope see back. (size)			
(5) screen 20 670-650 (length) (depth to top) 2 SS (size) (material)			
(6) pump 1 1/2 30 (HP) (yield gpm) elect (type power)			
(7) electric log NO. (yes or no)			
(organization running log)			
(8) how well bottom plugged back Press			
DRILLERS REMARKS:			

CODED

DEPT. OF NATURAL RESOURCES
BUREAU OF LAND & WATER RESOURCES
SEP 8 1980
RECEIVED


If well telescopes please sketch and show depths.

GROUND LEVEL

4" 140

2" 650

2" 670
screen

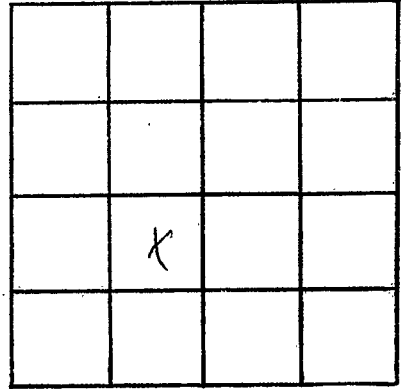

SECTION 18

Please indicate well location X.

ADDITIONAL INFORMATION

If more than one screen, show locations of each on sketch.