

MISSISSIPPI DEPARTMENT OF NATURAL RESOURCES

Bureau of Land and Water Resources

Southport Mall

P.O. Box 10631

Jackson, Mississippi 39209

WATER WELL DRILLERS LOG

CODED

Washington
AK 8 9/1
3/11/82

date well completed 3/11 1982 Larry's well & pump Washington
 Jim name county well located

LANDOWNER: Billy Harris

description of formations encountered

from

to

Hollandale MS.
 (mailing address)

clay 0 30
med sand 30 70
course sand 70 110

WELL LOCATION:

sec. 1 T 15 N R 6 E
 S W
5 miles East of Hollandale
 (distance) (direction) (nearest town)

WELL PURPOSE:

(home, irrigation, municipal, industrial)

WELL COMPLETION DATA:

- (1) diameter (inches) 8"
- (2) total depth (feet) 110'
- (3) static water level (feet) 24 below above top of ground.
- (4) casing PVC 70'
 (material) (depth)
- 8" if telescope see back.
 (size)
- (5) screen 40' 70'
 (length) (depth to top)
- 8" PVC
 (size) (material)
- (6) pump 15 A.P. 900
 (HP) (yield gpm)
- Elec.
 (type power)
- (7) electric log NO
 (yes or no)

CODED

(organization running log)

(8) how well bottom plugged PVC cap

DEPT. OF NATURAL RESOURCES
 BUREAU OF LAND & WATER RESOURCES


JUN 21 1982

RECEIVED

DRILLERS REMARKS:

If well telescopes please sketch and show depths.

GROUND LEVEL

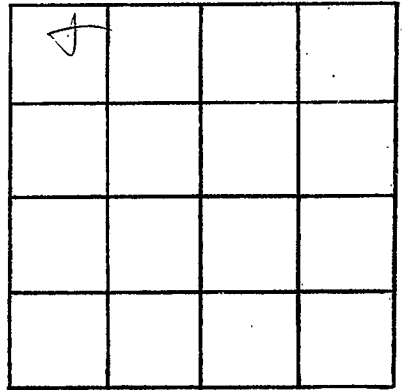

SECTION 1

Please indicate well location X.

ADDITIONAL INFORMATION

If more than one screen,
show locations of each on sketch.