

MISSISSIPPI DEPARTMENT OF NATURAL RESOURCES
Bureau of Land and Water Resources
 Southport Mall
 P.O. Box 10631
 Jackson, Mississippi 39209
WATER WELL DRILLERS LOG

CODED

996
EL-2686 WASHINGTON
4-10-84

4-10 19 84 LAYNE CENTRAL CO. WASHINGTON
 date well completed firm name county well located

LANDOWNER: BRUTON FARMS HOLLANDALE, MS (mailing address)	description of formations encountered	from	to
		clay	0
	coarse sand	25	35
	coarse sand/gravel	35	90
	large gravel boulders	90	121
WELL LOCATION:			
sec. <u>9</u> T. <u>15</u> N R. <u>6</u> W			
<u>2</u> miles <u>E</u> of <u>Hollandale</u> (distance) (direction) (nearest town)			
WELL PURPOSE: <u>irrigation</u> (home, irrigation, municipal, industrial)			
WELL COMPLETION DATA:			
(1) diameter (inches) <u>32"</u>			
(2) total depth (feet) <u>121'</u>			
(3) static water level (feet) <u>18'</u> below top of ground. <u>above</u>			
(4) casing <u>steel</u> <u>71'</u> (material) (depth) <u>16"</u> (size) if telescope see back.			
(5) screen <u>50'</u> <u>71'</u> (length) (depth to top) <u>16"</u> <u>st. steel</u> (size) (material)			
(6) pump <u>60</u> <u>2500</u> (HP) (yield gpm) <u>electric</u> (type power)			
(7) electric log <u>no</u> (yes or no) <u>(organization running log)</u> <u>st.plate</u>			
(8) how well bottom plugged _____			
DRILLERS REMARKS:			


DEPT. OF NATURAL RESOURCES
 BUREAU OF LAND & WATER RESOURCES

MAY 25 1984

RECEIVED

If well telescopes please sketch and show depths.

GROUND LEVEL

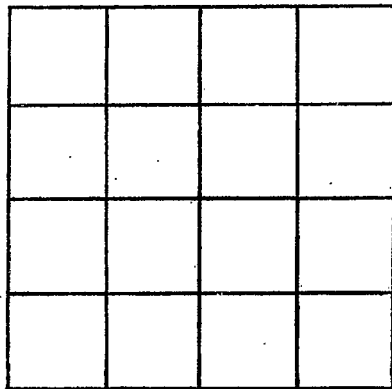

SECTION _____

Please indicate well location X.

ADDITIONAL INFORMATION

If more than one screen,
show locations of each on sketch.