

**MISSISSIPPI DEPARTMENT OF NATURAL RESOURCES**  
**Bureau of Land and Water Resources**  
 Southport Mall  
 P.O. Box 10631  
 Jackson, Mississippi 39209  
**WATER WELL DRILLERS LOG**

997  
CL-2695 WASHINGTON  
4-18-84

**CODED**

4-18 19 84 LAYNE CENTRAL CO. WASHINGTON  
 date well completed firm name county well located

LANDOWNER:	description of formations encountered	from	to
SHACKLEFORD FARMS INC. HOLLANDALE, MS (mailing address)			
	coarse sand	34	50
	coarse sand gravel	50	123
<b>WELL LOCATION:</b> sec. <u>26</u> T. <u>15</u> N. R. <u>6</u> E. W. <u>W</u> <u>6</u> miles W of <u>Murphy</u> (distance) (direction) (nearest town)			
<b>WELL PURPOSE:</b> <u>irrigation</u> (home, irrigation, municipal, industrial)			
<b>WELL COMPLETION DATA:</b>			
(1) diameter (inches) <u>32"</u>			
(2) total depth (feet) <u>123'</u>			
(3) static water level (feet) <u>26'</u> <u>below</u> <u>above</u> top of ground.			
(4) casing <u>steel</u> <u>83'</u> (material) (depth) <u>16"</u> if telescope see back. (size)			
(5) screen <u>50'</u> <u>83'</u> (length) (depth to top) <u>16"</u> <u>st. steel</u> (size) (material)			
(6) pump <u>60</u> <u>2500</u> (HP) (yield gpm) <u>electric</u> (type power)			
(7) electric log <u>no</u> (yes or no) <u>(organization running log)</u> <u>st. plate</u>			
(8) how well bottom plugged			
<b>DRILLERS REMARKS:</b>			


DEPT. OF NATURAL RESOURCES  
 BUREAU OF LAND & WATER RESOURCES

MAY 25 1984

**RECEIVED**

If well telescopes please sketch and show depths.

GROUND LEVEL

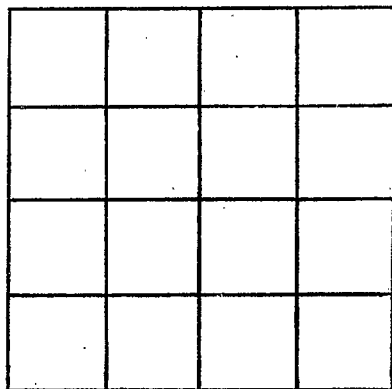

SECTION \_\_\_\_\_

Please indicate well location X.

ADDITIONAL INFORMATION

If more than one screen, show locations of each on sketch.