

MISSISSIPPI DEPARTMENT OF NATURAL RESOURCES

Bureau of Land and Water Resources

Southport Mall

P.O. Box 10631

CODED

Jackson, Mississippi 39209

WATER WELL DRILLERS LOG

WASHINGTON
P100

4-16 1984 date well completed
Larry's Well & Pump firm name
Washington county well located

LANDOWNER: Billy Ray Harris
Hollandale Ms
(mailing address)

description of formations encountered	from	to
<u>clay</u>	<u>0</u>	<u>30</u>
<u>Fine Sand</u>	<u>30</u>	<u>70</u>
<u>course Sand</u>	<u>70</u>	<u>120</u>

WELL LOCATION:
sec. 12 T 15 N
S R E
S W
5 miles East of Hollandale
(distance) (direction) (nearest town)

WELL PURPOSE:
(home, irrigation, municipal, industrial)

CODED

WELL COMPLETION DATA:

- (1) diameter (inches) 8"
- (2) total depth (feet) 120'
- (3) static water level (feet) 22 ^{below}/_{above} top of ground.
- (4) casing PUC, 80'
(material) (depth)
(size) If telescope see back.
- (5) screen 40', 80'
(length) (depth to top)
8", PUC
(size) (material)
- (6) pump 20 1100
(HP) (yield gpm)
E
(type power)
- (7) electric log No.
(yes or no)
(organization running log)
- (8) how well bottom plugged PUC
cap

DEPT. OF NATURAL RESOURCES
BUREAU OF LAND & WATER RESOURCES


OCT 12 1984

RECEIVED

DRILLERS REMARKS:

If well telescopes please
sketch and show depths.

GROUND LEVEL

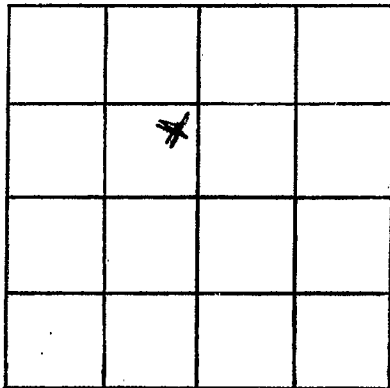

SECTION 12

Please indicate well location X.

ADDITIONAL INFORMATION

If more than one screen,
show locations of each on sketch.