

MISSISSIPPI DEPARTMENT OF NATURAL RESOURCES

Bureau of Land and Water Resources

Southport Mall

P.O. Box 10631

CODED

Jackson, Mississippi 39209

WATER WELL DRILLERS LOG

P101
Washington
2-21-84

Feb 21, 1984 Larry's well & pump Washington
date well completed fm name county well located

LANDOWNER: <u>Major Hogue</u>	description of formations encountered	from	to
<u>Hollandale, Ms.</u> (mailing address)	<u>Clay</u>	<u>0</u>	<u>30</u>
	<u>Sand & Gravel</u>	<u>30</u>	<u>190</u>
	<u>Sand</u>	<u>190</u>	<u>305</u>
	<u>Clay</u>	<u>305</u>	<u>410</u>
	<u>Sand</u>	<u>410</u>	<u>430</u>
	<u>Clay</u>	<u>430</u>	<u>440</u>
	<u>Sand</u>	<u>440</u>	<u>450</u>
	<u>Clay</u>	<u>450</u>	<u>460</u>
	<u>Sand</u>	<u>460</u>	<u>500</u>

LANDOWNER: Major Hogue

Hollandale, Ms.
(mailing address)

WELL LOCATION:
sec. 14 T. 15N R. 6E
S. 6 miles E of Hollandale
(distance) (direction) (nearest town)

WELL PURPOSE:
(home, irrigation, municipal, industrial)

WELL COMPLETION DATA: 120-4"

(1) diameter (inches) 4" x 2"

(2) total depth (feet) 500'

(3) static water level (feet) 25' below top of ground.

(4) casing PVC, 470
(material) (depth)

4x2 if telescope see back.
(size)

(5) screen 30', 470-500
(length) (depth to top)

2', .013 PVC
(size) (material)

(6) pump 1, 20
(HP) (yield gpm)

E-220
(type power)

(7) electric log NO
(yes or no)

(organization running log)


(8) how well bottom plugged Sand
Shank

DRILLERS REMARKS:

1-18-85
JTW

If well telescopes please
sketch and show depths.

GROUND LEVEL

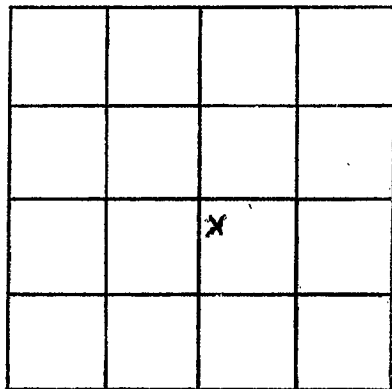

SECTION 14

Please indicate well location X.

ADDITIONAL INFORMATION

If more than one screen,
show locations of each on sketch.