

MISSISSIPPI DEPARTMENT OF NATURAL RESOURCES

Bureau of Land and Water Resources

Southport Mall

P.O. Box 10631

Jackson, Mississippi 39209

WATER WELL DRILLERS LOG *Washington*

**CODED**

*Washington*  
*P102*  
*1/2/85*

*1-2*  
date well completed

*85 Schultz Drilling*  
firm name

*Washington*  
*SHARKEY*  
county well located

LANDOWNER:  
*MURPHY Jones*  
*Panther Burn, MS*  
(mailing address)

description of formations encountered	from	to
TOPSOIL	0	20
COARSE sand + PERA gravel	20	140
COARSE SAND	140	250
CLAY	255	420
SAND	420	480
CLAY	480	535
SAND	535	625
CLAY	625	650
SAND	650	700
CLAY	700	720
SAND	720	820

WELL LOCATION:  
sec. *20* T. *15* S. R. *6* E.  
*4* miles *NE* of *Panther Burn*  
(distance) (direction) (nearest town)

WELL PURPOSE: *Home*  
(home, irrigation, municipal, industrial)

- WELL COMPLETION DATA:
- (1) diameter (inches) *4" x 2"*
  - (2) total depth (feet) *800'*
  - (3) static water level (feet) *32'* below top of ground.
  - (4) casing *PVC* *770'*  
(material) (depth)
  - (size) if telescope see back.
  - (5) screen *30'* *770'*  
*2"* (length) (depth to top)  
*PVC* (material)
  - (6) pump *1 1/2* *25*  
(HP) (yield gpm)  
*el* (type power)
  - (7) electric log *No*  
(yes or no)  
(organization running log)
  - (8) how well bottom plugged *b/w*



**CODED**

**RECEIVED**  
JAN 28 1985

Department of Natural Resources  
Bureau of Land & Water Resources

DRILLERS REMARKS:

If well telescopes please sketch and show depths.

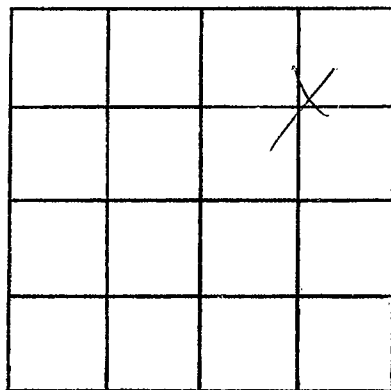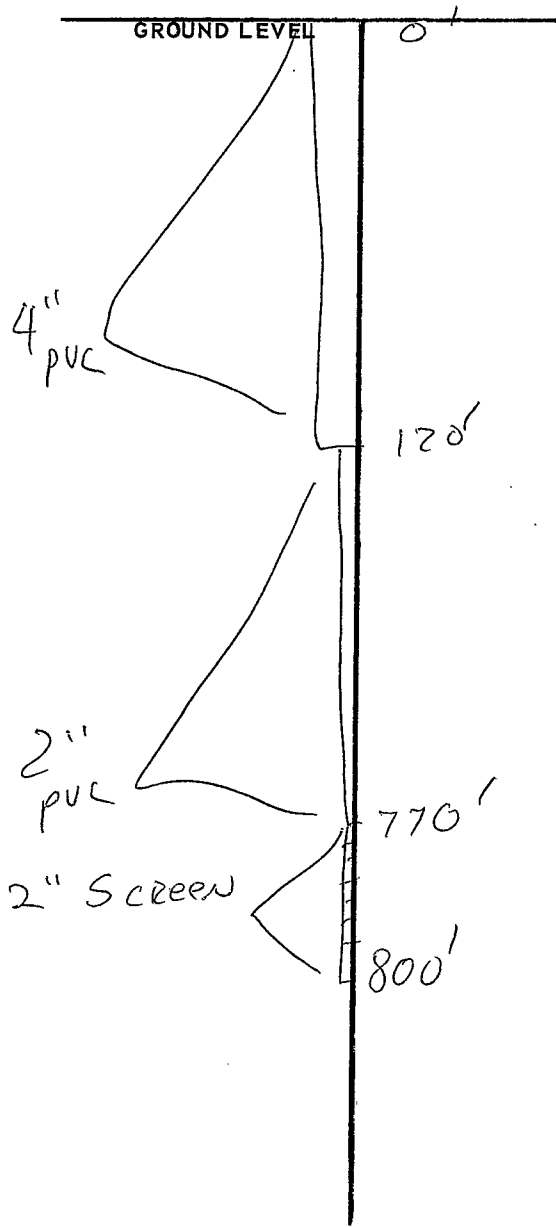

SECTION 20

Please indicate well location X.

**ADDITIONAL INFORMATION**

If more than one screen, show locations of each on sketch.