

MISSISSIPPI DEPARTMENT OF NATURAL RESOURCES
Bureau of Land and Water Resources
 Southport Mall
 P.O. Box 10631
 Jackson, Mississippi 39209
WATER WELL DRILLERS LOG

WASHINGTON
 et-2983-P103

CODED

4-17 1985 LAYNE-CENTRAL CO. WASHINGTON
 date well completed firm name county well located

LANDOWNER:
 HOLLINGSWORTH FARMS
 HOLLANDALE, MS
 (mailing address)

description of formations encountered	from	to
clay	0	18
coarse sand	18	50
coarse sand/pea gravel	50	85
coarse sand /gravel	85	123

WELL LOCATION:
 sec. 27 T. 15 N. R. 6 W.
 4 miles SE Hollandale
 (distance) (direction) (nearest town)

CODED

WELL PURPOSE: irrigation
 (home, irrigation, municipal, industrial)

WELL COMPLETION DATA:

(1) diameter (inches) 32"
 (2) total depth (feet) 123'
 (3) static water level (feet) 19' below top of ground.
 (4) casing steel 73'
 (material) (depth)
 16" if telescope see back.
 (size)
 (5) screen 50' 73'
 (length) (depth to top)
 16" st. steel
 (size) (material)
 (6) pump 60 3000
 (HP) (yield gpm)
 elec
 (type power)
 (7) electric log no
 (yes or no)
 (organization running log) st. plate
 (8) how well bottom plugged

RECEIVED


JUL 8 1985

DRILLERS REMARKS:

Department of Natural Resources
 Bureau of Land & Water Resources

If well telescopes please sketch and show depths.

GROUND LEVEL

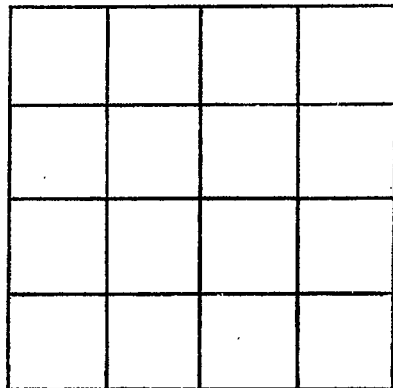

SECTION _____

Please indicate well location X.

ADDITIONAL INFORMATION

If more than one screen,
show locations of each on sketch.