

MISSISSIPPI DEPARTMENT OF NATURAL RESOURCES

Bureau of Land and Water Resources

Southport Mall

P.O. Box 10631

Jackson, Mississippi 39209

WATER WELL DRILLERS LOG

WASHINGTON
P107

CODED

7-20-87, 19
date well completed

Schultz Drilling
firm name

Washington
county well located

LANDOWNER: GAINER

P.O. Box 36
Holland Ms. 38748
(mailing address)

description of formations encountered

from

to

CLAY 0 20
SAND 20 80
SAND + GRAVEL 80 130

WELL LOCATION:

sec. 7 T 15 N R. 6 E
3 miles S of Holland
(distance) (direction) (nearest town)

WELL PURPOSE: IRRIGATION
(home, irrigation, municipal, industrial)

WELL COMPLETION DATA:

- (1) diameter (inches) 16"
- (2) total depth (feet) 130'
- (3) static water level (feet) 31' below above top of ground.
- (4) casing PVC, 70' (material), (depth)
- (5) screen 60" 70" (size), (depth to top)
16" (length), PVC (material)
- (6) pump 60 3000 (HP), (yield gpm)
pto (type power)
- (7) electric log NO (yes or no)
X (organization running log)
- (8) how well bottom plugged cap

RECEIVED


OCT 05 1987

Department of Natural Resources
Bureau of Land & Water Resources

DRILLERS REMARKS:

If well telescopes please sketch and show depths.

GROUND LEVEL

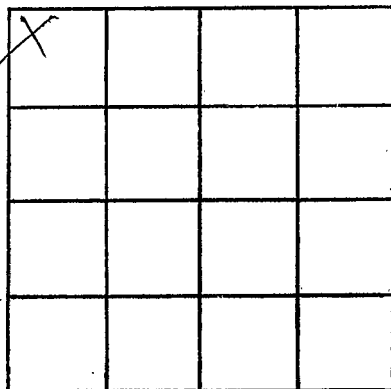

SECTION 7

Please indicate well location X.

ADDITIONAL INFORMATION

If more than one screen, show locations of each on sketch.