

MISSISSIPPI DEPARTMENT OF NATURAL RESOURCES

Bureau of Land and Water Resources

P.O. Box 10631
Jackson, Mississippi 39209
WATER WELL DRILLERS LOG

COUNTY WELL LOCATED <i>Washington</i>	
WELL NUMBER <i>P109</i>	CODED <input checked="" type="checkbox"/>
DATE WELL COMPLETED <i>4-12-87</i>	

PERMIT NUMBER <i>MS-GW-03336</i>
NAME OF DRILLING FIRM <i>Larry's well & pump</i>

NAME & MAILING ADDRESS OF LANDOWNER <i>Carey Bayou Farms, Inc. Craig Bayou P.O. Box 129 Delta City, Ms. 39064</i>			
WELL LOCATION: SEC	TOWNSHIP	RANGE	
<i>W1/4 W1/4 35</i>	<i>15</i>	<i>6</i>	
DISTANCE	DIRECTION	NEAREST TOWN	
<i>2</i> Miles	<i>N</i>	of <i>Delta City</i>	
OTHER LANDMARK			
WELL PURPOSE: Home <input checked="" type="checkbox"/> Irrigation <input type="checkbox"/> Municipal, industrial, Fish Pond, etc.			

PUMP DATA		
PUMP TYPE (Circle One): Submersible, Turbine, Jet, Flowing Well, Other (Describe) _____		
POWER TYPE (Circle One): Electric, Tractor, <input checked="" type="checkbox"/> Diesel, Gasoline, Butane, Other (Describe) _____		
Pump Capacity (GPM) <i>1500</i>	No. of Stages <i>2</i>	Setting Depth <i>60</i> FT.
PUMP TEST <i>none</i>		
Well yielded _____ GPM with a drawdown of _____ ft. after _____ hours of pumping		

WELL DATA		
Well Depth <i>116'</i>	Casing Diameter (In.) <i>12"</i>	Casing Length (Ft.) <i>76'</i>
Type of Casing <i>Steel</i>	Hole Depth <i>116'</i>	Depth to Static Water Level <i>24'</i>
TYPE OF COMPLETION: (Circle One or More): <input checked="" type="checkbox"/> Gravel Packed, <input type="checkbox"/> Underreamed, <input type="checkbox"/> Telescoped, <input type="checkbox"/> Natural Development, <input type="checkbox"/> Open Hole, <input type="checkbox"/> Other (Describe) _____		
Top of Lap Pipe or Reduction in Casing		
FEET <input type="checkbox"/> IF TELESCOPED OR MORE THAN ONE SCREEN: USE BACK PAGE		


LOG DATA	
TYPE OF LOG RUN (Circle One): Electric, Gamma Ray, Density, Sonic, <input checked="" type="checkbox"/> No Log Run, Neutron, Other (Describe) _____	
Name of Organization Running Log	

SCREEN DATA		
Diameter - Inches <i>12"</i>	Length - Feet <i>40'</i>	Slot Size - Inches <i>.060</i>
Screen Type <i>Steel</i>		Depth to Bottom - Feet <i>116'</i>

GEOLOGIC DATA (Office Use Only)			
Surface Elev.	Geologic Unit	Unit Thickness	Depth to Top
Subs. SWL	Date	Analysis	Aquifer Test


Driller's Remarks

DESCRIPTION OF FORMATIONS ENCOUNTERED	FROM	TO
<i>clay</i>	<i>0</i>	<i>30</i>
<i>fine sand</i>	<i>30</i>	<i>60</i>
<i>coarse sand & gravel</i>	<i>60</i>	<i>116</i>

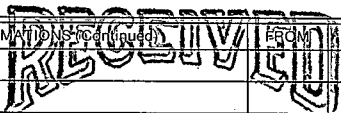 DEC 02 1987 Department of Natural Resources Bureau of Land & Water Resources	FROM: _____ TO: _____ IF MORE SPACE IS NEEDED, USE BACK
---	--

If well telescopes please
sketch and show depths.

GROUND LEVEL

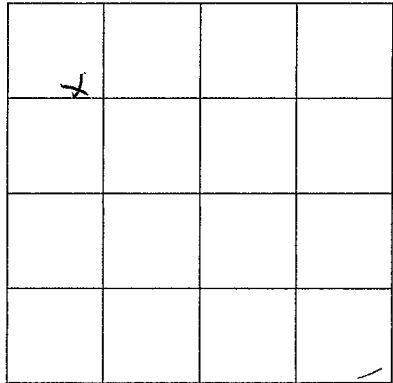

SECTION 35

Please indicate well location X.

ADDITIONAL INFORMATION

If more than one screen,
show location of each on sketch.