

MISSISSIPPI DEPARTMENT OF NATURAL RESOURCES

Bureau of Land and Water Resources

Southport Mall

P.O. Box 10631

Jackson, Mississippi 39209

WATER WELL DRILLERS LOG

Coded

Permit Applied For P 110

5-28 1988 date well completed

88 Dyer Well firm name

Washington county well located

LANDOWNER: James Dyer  
RT 2 Box 21  
Hollandale Ms  
(mailing address)

description of formations encountered	from	to
Clay	0	28
Fine Sand	28	45
Fine Sand & Gravel	45	60
Fine Sand	60	70
Sand & Gravel	70	115

WELL LOCATION:  
sec. 9 T 15 N R 6 E  
3 miles SE of Hollandale  
(distance) (direction) (nearest town)

WELL PURPOSE: Irrigation  
(home, irrigation, municipal, industrial)

- WELL COMPLETION DATA:
- (1) diameter (inches) 16"
  - (2) total depth (feet) 115'
  - (3) static water level (feet) \_\_\_\_\_ below top of ground.
  - (4) casing steel (material), \_\_\_\_\_ (depth), 16" (size) If telescope see back.
  - (5) screen 40' (length), \_\_\_\_\_ (depth to top), 16" (size) (material)
  - (6) pump 60 (HP), \_\_\_\_\_ (yield gpm), Gear (type power)
  - (7) electric log No (yes or no), None (organization running log)
  - (8) how well bottom plugged Plate

RECEIVED


JUN 06 1988

Department of Natural Resources  
Bureau of Land & Water Resources

DRILLERS REMARKS:

If well telescopes please  
sketch and show depths.

GROUND LEVEL

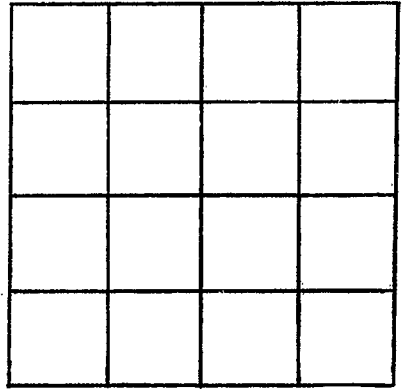

SECTION \_\_\_\_\_

Please indicate well location X.

ADDITIONAL INFORMATION

If more than one screen,  
show locations of each on sketch.