

MISSISSIPPI DEPARTMENT OF NATURAL RESOURCES

Bureau of Land and Water Resources

COUNTY WELL LOCATED
Washington

WELL NUMBER
P 116

DATE WELL COMPLETED
6-2-89

PERMIT NUMBER
166B

NAME OF DRILLING FIRM
IRRIGATION EQUIPMENT

PHONE NUMBER
601/887-2555

CODED

P.O. Box 10631
Jackson, Mississippi 39209
WATER WELL DRILLERS LOG

NAME & MAILING ADDRESS OF LANDOWNER
DAN. Theunissen
Rt. 2, BOX 127-A
Hollandale, MS

WELL LOCATION: SEC **12** TOWNSHIP **15** RANGE **6**

DISTANCE **6** Miles **EAST** of **Hollandale**

OTHER LANDMARK

WELL PURPOSE: Home, Irrigation, Municipal, Industrial, Fish Pond, etc.
IRRIGATION

PUMP DATA

PUMP TYPE (Circle One):
Submersible, **Turbine**, Jet Flowing Well,
Other (Describe)

POWER TYPE (Circle One):
Electric, Tractor, Diesel, Gasoline, **Butane**,
Other (Describe) **H/P 60**

Pump Capacity (GPM) **3000** No. of Stages **1** Setting Depth **60** FT.

PUMP TEST

Well yielded _____ GPM with
a drawdown of _____ ft.
after _____ hours of pumping

WELL DATA

Well Depth **15'** Casing Diameter (In.) **16** Casing Length (Ft.) **75**

Type of Casing **steel** Hole Depth **115'** Depth to Static Water Level **30'**

TYPE OF COMPLETION: (Circle One or More):
Gravel Packed, Underreamed, Telescoped,
Natural Development, Open Hole, Other

Top of Lap Pipe or Reduction in Casing
FEET **115** IF TELESCOPED OR MORE THAN ONE SCREEN: USE BACK PAGE

LOG DATA

TYPE OF LOG RUN (Circle One): No Log Run,
Electric, Gamma Ray, Density, Sonic, Neutron,
Other (Describe)

Name of Organization Running Log

SCREEN DATA

Diameter - Inches **16** Length - Feet **40** Slot Size - Inches **.060**

Screen Type **steel** Depth to Bottom - Feet **115**

GEOLOGIC DATA (Office Use Only)

Surface Elev.	Geologic Unit	Unit Thickness	Depth to Top
Subs. SWL	Date	Analysis	Aquifer Test

Driller's Remarks
Tims pump

DESCRIPTION OF FORMATIONS ENCOUNTERED	FROM	TO	FORMATIONS (Continued)	FROM	TO
Clay	0	15	RECEIVED NOV 03 1989		
Fine SAND	15	60			
medium SAND	60	70			
COARSE SAND	70	75			
medium SAND	75	85			
COARSE SAND + GRAVEL	85	115			


Department of Natural Resources
Bureau of Land & Water Resources

IF MORE SPACE IS NEEDED, USE BACK

If well telescopes please sketch and show depths.

IRRIGATION EQUIPMENT
601/887-2555
INDIANOLA, MS

GROUND LEVEL

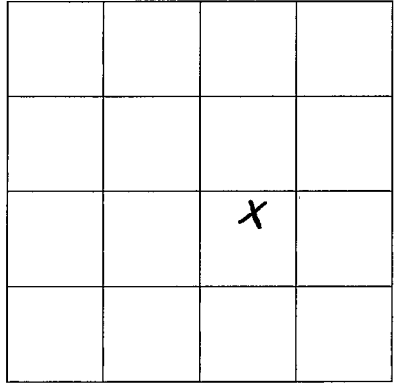

SECTION 12

Please indicate well location X.

ADDITIONAL INFORMATION

If more than one screen,
show location of each on sketch.