

matched to 04435

**MISSISSIPPI DEPARTMENT OF ENVIRONMENTAL QUALITY**

Office of Land and Water Resources

COUNTY WELL LOCATED	
Washington	
WELL NUMBER P-132	CODED
DATE WELL COMPLETED 7-11-02	

PERMIT NUMBER GW44160
NAME OF DRILLING FIRM Irrigation Equipment Inc.
Indianola, MS

P. O. Box 10631  
Jackson, MS 39289-0631  
**WATER WELL DRILLERS LOG**

NAME & MAILING ADDRESS OF LANDOWNER  
Greer & Greer Farms  
Box 637  
Hollandale, MS 38748

Latitude:  
Longitude:

WELL LOCATION.	SEC	TOWNSHIP	RANGE	
NE/NE	24	15N	S 6W	E W
DISTANCE	DIRECTION	NEAREST TOWN		
Miles	SE	Hollandale		

OTHER LANDMARK

WELL PURPOSE: Home, Irrigation, Municipal, Industrial, Fish Pond, etc.  
Irrigation

**WELL DATA**

Well Depth 115	Casing Diameter (In.) 16	Casing Length (Ft.) 75
Type of Casing pvc	Hole Depth 115	Depth to Static Water Level 31ft.

TYPE OF COMPLETION: (Circle One or More):  
 Gravel Packed,     Underreamed,     Telescoped,  
 Natural Development,     Open Hole,     Other  
 (Describe)

WELL GROUTED TO A DEPTH OF \_\_\_\_\_ FEET  
 Type Grout (circle one): Cement, Bentonite, or Mix

**SCREEN DATA**

Diameter - Inches 16	Length - Feet 40	Slot Size - Inches .050
Screen Type pvc	Depth to Bottom - Feet 115	

**PUMP DATA**

PUMP TYPE (Circle One):  
 Submersible,     Turbine,    Jet    Flowing Well,  
 Other (Describe)

POWER TYPE (Circle One):  
 Electric, Tractor,     Diesel,    Gasoline,    Butane,  
 Other (Describe)    H/P    60

DESCRIPTION OF FORMATIONS ENCOUNTERED	FROM	TO
Clay	0	18
Fine Sand	18	60
Fine Sand/gravel	60	68
Med. Sand/gravel	68	115

RECEIVED

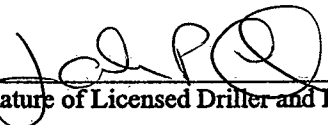
SEP 06 2002

BY: OLWR

Top of Lap Pipe or Reduction in Casing

FEET    IF TELESCOPED OR MORE THAN ONE SCREEN: USE BACK PAGE

I certify that the well was drilled, constructed and completed in accordance with all applicable Requirements of the Mississippi Department of Environmental Quality and/or the Mississippi Department of Health regulations and state laws.

 0439  
 Signature of Licensed Driller and License No.

9-4-02  
 Date

Additional Information Required On Back

If well telescopes please sketch and show depths.

GROUND LEVEL

			X

SECTION 24

Please indicate well location X.

Pump Capacity (GPM)	No. of Stages	Setting Depth
2500 to 3000	1	70 FT.

PUMP TEST

Well yielded \_\_\_\_\_ GPM with  
a drawdown of \_\_\_\_\_ ft.  
after \_\_\_\_\_ hours of pumping

**LOG DATA**

TYPE OF LOG RUN (Circle One): No Log Run, Electric, Gamma Ray, Density, Sonic, Neutron, Other (Describe) \_\_\_\_\_

Name of Organization Running Log \_\_\_\_\_

**GEOLOGIC DATA (Office Use Only)**

Surface Elev.	Geologic Unit	Unit Thickness	Depth to Top
Subs. SWL	Date	Analysis	Aquifer Test

Driller's Remarks


If more than one screen, show location of each on sketch.