
GENE STOCK - IVEY PLACE

	State W	ell Report				
County: WASHINGTON	Part 1 – Driller's Log		For Office Use Only:			
Permit #: GW - 45666	Mississippi Department of Environmental Quality Office of Land and Water Resources		Aquifer: 184			
Driller: J. NEWCOME 0.773	P.O. Box 2309		Well #:			
	Jackson, MS 39225 (601)961- 5210		L. S. Elevation:			
Date drilling completed: 2.29.2012		1- 5228 (fax)				
State I any requires that this repair] rt he prepared by the lie	ansa haldan nasmansihla fan	E-log #:			
State Law requires that this report be prepared by the license holder responsible for the work and filed with the Department at the above address within 30 days of completion of drilling of the well or borehole.						
Information on Well Owner			orehole Location		7	
(Landowner if borehole is not for a water well) Owner Name Parkinson Amy and Maraguite (1945		Latitude: 33 .09 .49	" Longitude: <u>90</u> · 4	<u>1.05</u> .,		
Owner Name Parkinson, Amy and Margarite Crews Mailing Address: 707 Sonty Main Street		Method of Lat/Long (circle one): Conventional Survey,				
	USGS quad Hand-held GPS Survey-grade GPS					
	NO 1/4 NE 1/4 Sec 09	Twn (5/ Rng	044			
Greenville Me	SE					
	te Zip Code	Distance Direction	of HoughDave	3		
Telephone No. ()						
Well / Borehole Data						
Date drilling started: 2.29.12 Date drilling completed: 2.29.12 Hole depth: 1/2 Hole diameter: 24"						
Location of the source of any surface water used for drilling:						
Method of dosing and volume of Chlorine used in drilling and development: CHLORINE TABLETS						
Logs run (circle all applicable) - 100 log run Electric Gamma Ray Density Sonic Neutron Other:						
Purpose of borehole (check one): Water Well Geotechnical/Geological Investigation Ground Source Heat Pump						
Seismic Survey Other (describe)						
If drilling is not related to water well construction, skip the remainder of this block						
Purpose of Well (check one): Home Industrial Public Supply Irrigation X Fish Culture Other:						
If a flowing well, method of flow regulation: Valve Other (describe)						
Static Water Level:feet above or below (circle one) land surface Date measured:						
Method of Measurement (circle one) steel tape electric tape air line other:						
Well depth: <u>HO</u> Well grouted to a depth of <u>D</u> feet Type of grout (circle one): Neat Cement Bentonite Mix						
Casing length: <u>70</u> feet Casing diameter: <u>16</u> inches Type of casing: <u>P.V.C.</u>						
Screen length: <u>40</u> feet Screen diameter: <u>16</u> inches Type of screen: <u>4.V.C</u> .						
Screen slot size: <u>.050</u> inches Setting depth: From <u>60 - 80</u> feet to <u>90 - 110</u> feet						
Type of completion (circle all applicable): Gravel packet Underreamed Telescoped Open hole Natural Development						
	Other (describe):			-		
Top of lap pipe or reduction in casing:	feet. <u>If tel</u>	escoped or more than one scree		_		
Form: OLWR-SWR-1A (04/08)						
				REC	CEIVED	
				APR	0 5 2012	
				BY:	OLWR	

The sketch below only required for water wells

Description of formations encountered must be provided for all wells and boreholes, unless specifically exempted by regulations

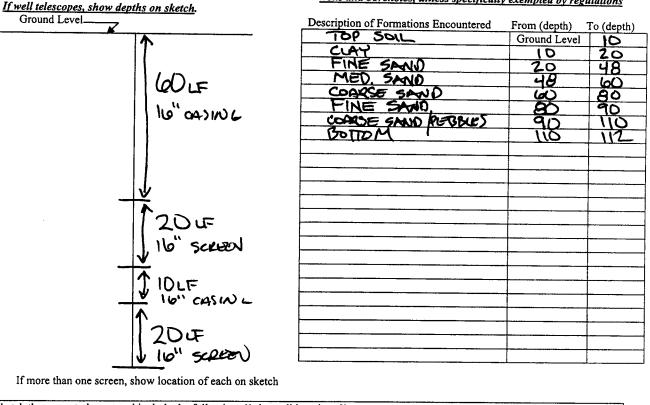

Sketch the property layout and include the following: 1) the well location; 2) any permanent structures on the property that may

aid in locating the well; 3) any roads, power lines, or other items that may aid in locating the property and the well; 4) a north arrow. Landowner Name: Form: OLWR-SWR-1A (04/08)

I certify that the well/borehole was drilled, constructed, and completed in accordance with all applicable requirements of the Mississippi Department of Environmental Quality and the Mississippi Department of Health regulations, if applicable, and state

laws. 0773 279.2012 LEWCOME JOHN Date

Print Name of Responsible Licensee and License No.

a Signature of Licensee

СТАТЕХЛ	ELL REPORT			
	art 2 For Office Use Only:			
Pump Installer'	s Completion Report Aquifer: to f Environmental Quality			
Driller:) New Come 0-773 Office of Land	and Water Resources Box 2309 Weil #: <u>P184</u>			
Date completed: 2/29/12 Jackson	n, MS 39225 Elevation:			
(601)961-5210 51-5228 (fax)			
This part of the report must be completed by a licensed water well contractor or a licensed pump installer. A copy of Part 1 of the report must be attached and both parts filed with the Department at the above address within 30 days of well completion.				
Well Owner Information	Well Location			
Owner Name Partimson, Any + Margrite Creu	Latitude: <u>3309 49</u> Longitude: <u>90 49 05</u>			
Mailing Address: 707 South Main St.	Method of Lat/Long (check one): Conventional Survey,			
	USGS quad, Hand-held GPS Survey-grade GPS			
City State Zip Code	NW 1/ NE 1/ Sec 09 TISN R G W			
Telephone No. ()	Distance Direction Nearest Town <u>1.5</u> Miles <u>C</u> of <u>Hollomdaly</u>			
Pump Type Circle one	Power Type Circle one			
Air Lift Jet Submersible	Diesel Engine Gasoline Engine Natural Gas			
Bucket Piston Turbine	Electric Motor Hand Tractor PTO			
Centrifugal Rotary Flowing Well	Windmill Other (specify):			
Other (specify):	Horse Power Rating of Motor: <u>30 hp</u>			
Date Pump Installed: 3/8/12	Setting Depth:			
Rated Pump Capacity: 1200 Gallons Per Minute	Number of Stages:			
Pump Test Data	Method of Measuring Water Level			
Date Well Tested:	Circle one Air Line Electric Measuring Line Steel Tape			
Static Water Level (A):Feet Below Land Surface	Other (specify):			
Pumping Water Level (B):Feet Below Land Surface				
Drawdown [(B) - (A)]: Feet Below Land Surface	For flowing well, measured shut in head:feet			
Test Pumping Rate:Gallons Per Minute	Well yielded GPM with a drawdown of			
Duration of Pump Test (minimum 4 hours):hours	feet afterhours of pumping			
This is for (circle one): New Well Replacement of Existing Pump Repair of Existing Pump				
I UEDEDV CEDTIEV that the above statements are the state in the				
I HEREBY CERTIFY that the above statements are true to the best of my knowledge Comp Rowe 0-711P Dist News of Parts Installing and Linguist No. (if any linguist)				
Print Name of Pullip Installer and License No. (if applicable) Signature of Pullip Installer Form: OLWR-SWR-16-072092				
	BY: OLWF			

.

• • •