

Washington
 P 2000
 5/26/76

MISSISSIPPI
 BOARD OF WATER COMMISSIONERS
 416 North State Street
 15H Jackson, Mississippi 39201

WATER WELL DRILLERS LOG

May 26 1976 date well completed
 76 Schultz Drilling firm name
 Washington county well located

LANDOWNER: Glover Arington
 description of formations encountered: Aviation
 from: 0 to: 23
 Hallandale Miss (mailing address) c/o [unclear]

WELL LOCATION:
 sec. 5 T. 15 N. R. 10 E. W. 1
 1 miles NE of Hallandale
 (distance) (direction) (nearest town)

WELL PURPOSE: drill
 (home, irrigation, municipal, industrial)

- WELL COMPLETION DATA:
- (1) diameter (inches) 4"
 - (2) total depth (feet) 65
 - (3) static water level (feet) 14 below top of ground
 - (4) casing PVC
 (material) (depth)
 (size) If telescope see back.
 - (5) screen 5
 (length) (depth to top)
4" PVC
 (size) (material)
 - (6) pump —
 (HP) (yield gpm)
 (type power)
 - (7) electric log (yes or no)
 (organization running log)
 - (8) how well bottom plugged CAP


DRILLERS REMARKS:

RECEIVED
 AUG 24 1976

MISS. BD. OF WATER COMMISSIONERS

If well telescopes please sketch and show depths.

GROUND LEVEL

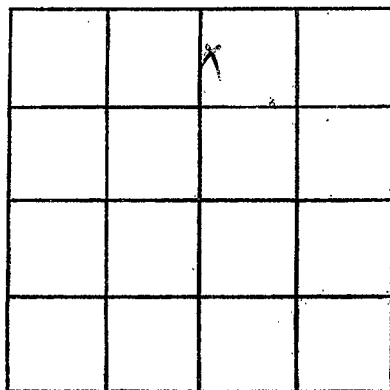

SECTION 5

Please indicate well location X.

ADDITIONAL INFORMATION

If more than one screen, show locations of each on sketch.