

Washington
 P 2001
 7/8/76

MISSISSIPPI
 BOARD OF WATER COMMISSIONERS
 416 North State Street
 Jackson, Mississippi 39201

WATER WELL DRILLERS LOG

July 8 1976 date well completed
 Schultz Drilling firm name
 Washington county well located

LANDOWNER: JACK NEWTON	description of formations encountered	from	to
Hollandale Miss (mailing address)	Clay	0	18
	Sand + Gravel	18	143
WELL LOCATION: sec. 3 T. 15 N. R. 6 E 3 miles E of Hollandale	Clay	143	188
	Sand	188	210
WELL PURPOSE: Home (home, irrigation, municipal, industrial)	Clay	210	286
WELL COMPLETION DATA:	Sand	286	300
(1) diameter (inches) 2" x 4"	Shale	300	3100
(2) total depth (feet) 380			
(3) static water level (feet) 20 below top of ground.			
(4) casing PVC (material) (depth) (size) If telescope see back.			
(5) screen 20 (length) (depth to top) 2" (size) PVC (material)			
(6) pump 1 (HP) 25 (yield gpm) (type power)			
(7) electric log NO (yes or no) (organization running log)			
(8) how well bottom plugged flush			
DRILLERS REMARKS:			


RECEIVED

AUG 24 1976

MISS. BD. OF WATER COMMISSIONERS

If well telescopes please sketch and show depths.

GROUND LEVEL

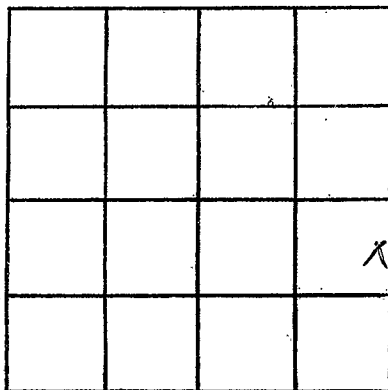

SECTION 3

Please indicate well location X.

ADDITIONAL INFORMATION

If more than one screen, show locations of each on sketch.