

Washington

P 2000

6/4/76

MISSISSIPPI
 BOARD OF WATER COMMISSIONERS
 416 North State Street
 155 Jackson, Mississippi 39201

WATER WELL DRILLERS LOG

JUNE 4 1976
date well completed

Schultz Drilling
firm name

Washington
county well located

LANDOWNER: D.A. Cook

description of formations encountered

from

to

Hallendale Miss
(mailing address)

Top 5' of clay
sand 0 18

WELL LOCATION:

sec 5 T 15 N R 6 E
W
1/2 miles E of Hallendale
(distance) (direction) (nearest town)

clay
sand 18 136
136 210
210 230

WELL PURPOSE: Home
(home, irrigation, municipal, industrial)

shel + sand 230 305

WELL COMPLETION DATA:

sand 305 400

- (1) diameter (inches) 4" x 2"
- (2) total depth (feet) 400
- (3) static water level (feet) 26 below top of ground.

(4) casing P.V.C.
(material) (depth)

4x2 If telescope see back.
(size)

(5) screen 20
(length) (depth to top)

2" P.V.C.
(size) (material)

(6) pump 1 25
(HP) (yield gpm)

Elec
(type power)

(7) electric log NO
(yes or no)

(organization running log)

(8) how well bottom plugged
A wash

RECEIVED



AUG 24 1976

DRILLERS REMARKS:

MISS. BD. OF WATER COMM

If well telescopes please sketch and show depths.

GROUND LEVEL

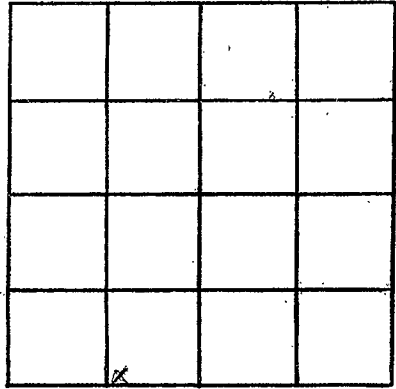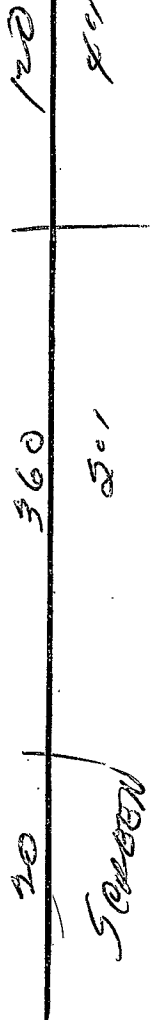

SECTION 5

Please indicate well location X.

ADDITIONAL INFORMATION

A series of horizontal lines for recording additional information.

If more than one screen, show locations of each on sketch.