

Washington
P 2003
9/5/76

MISSISSIPPI
BOARD OF WATER COMMISSIONERS
416 North State Street
Jackson, Mississippi 39201

WATER WELL DRILLERS LOG


5 Sept 1976 date well completed
Lambert Drilling firm name
Wash county well located

LANDOWNER:	description of formations encountered	from	to
Charles? Chor. Mitchell	m. ved.	0	30
Hollandale Miss. (mailing address)	sand	30	60
WELL LOCATION: sec. 10 T 15 N R. 6 E 4 miles E of Hollandale (distance) (direction) (nearest town)	gravel	60	130
WELL PURPOSE: none (home, irrigation, municipal, industrial)	Shell	130	135
WELL COMPLETION DATA: (1) diameter (inches) 2 (2) total depth (feet) 425 (3) static water level (feet) 30 below above top of ground. (4) casing PVC 415 (material) (depth) (size) If telescope see back. (5) screen 10 425-415 (length) (depth to top) 2 PVC (size) (material) (6) pump 1 10 (HP) (yield gpm) elect (type power) (7) electric log (yes or no) (organization running log) (8) how well bottom plugged back Wash	Clay sandst	135	300
DRILLERS REMARKS:	sand	300	350
	sand, st. clay	350	390
	sand	390	430

RECEIVED
OCT 28 1976
MISS. BU. OF WATER COMMISSIONERS

If well telescopes please sketch and show depths.

GROUND LEVEL

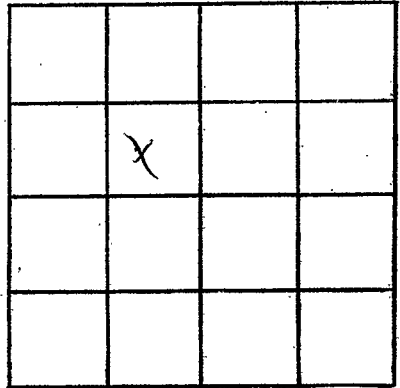

SECTION 10

Please indicate well location X.

ADDITIONAL INFORMATION

If more than one screen,
show locations of each on sketch.