

WASHINGTON

P 2005

11/15/76

MISSISSIPPI
BOARD OF WATER COMMISSIONERS
416 North State Street
Jackson, Mississippi 39201

155

WATER WELL DRILLERS LOG

15 Nov. 1976
date well completed

Lambert Drilling Wash.
firm name county well located

LANDOWNER:
Joe Create
Hollandale
(mailing address)

description of formations encountered	from	to

WELL LOCATION:
sec 17 T. 15 N. R. 6 E.
2 miles SF of Hollandale
(distance) (direction) (nearest town)

Clay	0	15
Sand	15	60
Pea gravel	60	120
Sand gravel	120	165

WELL PURPOSE: none
(home, irrigation, municipal, industrial)

Sand	165	205
------	-----	-----

WELL COMPLETION DATA:
(1) diameter (inches) 2
(2) total depth (feet) 505
(3) static water level (feet) 32 below above top of ground.
(4) casing PVC 495 (material) (depth)
(size) If telescope see back.
(5) screen 10 505 (length) (depth to top)
2 PVC (size) (material)
(6) pump 1 10 (HP) (yield gpm)
elect (type power)
(7) electric log (yes or no)
(organization running log)
(8) how well bottom plugged back wash


Clay	205	285
sand st clay	285	405
Sand	405	465
sand gravel	465	570

DRILLERS REMARKS:

RECEIVED
JAN 10 1977
OF WATER COMMISSION

If well telescopes please
sketch and show depths.

GROUND LEVEL

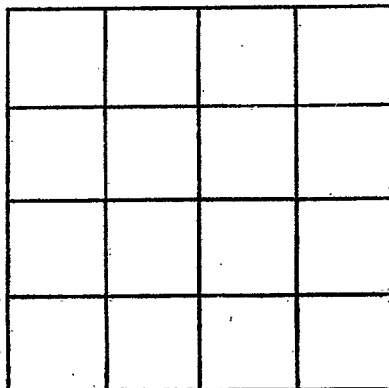

SECTION _____

Please indicate well location X.

ADDITIONAL INFORMATION

If more than one screen,
show locations of each on sketch.