

Washington
 P 0005
 10/11/77

MISSISSIPPI
 BOARD OF WATER COMMISSIONERS
 416 North State Street
 Jackson, Mississippi 39201

WATER WELL DRILLERS LOG

Oct 11 1977 Schultz Diddy Co Washington
 date well completed firm name county well located


LANDOWNER: <u>Re Euphonia Hollanclake</u>	description of formations encountered	from	to
(mailing address)			

<u>SAND</u>	<u>60</u>	<u>137</u>
<u>Clay</u>	<u>137</u>	<u>320</u>
<u>SAND</u>	<u>320</u>	<u>360</u>

WELL LOCATION:
 sec. 5 T. 50 N R. 6 E
1 miles PAST of Hollanclake
 (distance) (direction) (nearest town)

WELL PURPOSE: home
 (home, irrigation, municipal, industrial)

- WELL COMPLETION DATA:
- (1) diameter (inches) 4 1/2
 - (2) total depth (feet) 360
 - (3) static water level (feet) 21 below above top of ground.
 - (4) casing PVC 340
 (material) (depth)
 (size) if telescope see back.
 - (5) screen 20 340
 (length) (depth to top)
2 in PVC
 (size) (material)
 - (6) pump 1 19
 (HP) (yield gpm)
 (type power)
 - (7) electric log _____
 (yes or no)
 (organization running log)
 - (8) how well bottom plugged b/w

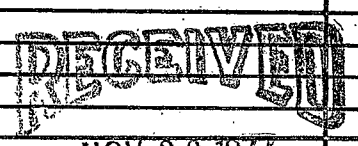


NOV 30 1977

DRILLERS REMARKS:
 MISS. BD. OF WATER COMM

If well telescopes please sketch and show depths.

GROUND LEVEL

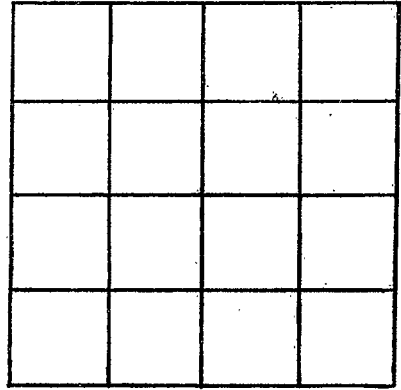

SECTION _____

Please indicate well location X.

ADDITIONAL INFORMATION

Lined area for recording additional information. It consists of 21 horizontal lines below the header.

If more than one screen,
show locations of each on sketch.