

WASHINGTON

MISSISSIPPI BOARD OF WATER COMMISSIONERS
416 North State Street
Jackson, Mississippi 39201

2000 P

5-10-78

WATER WELL DRILLERS LOG

5-10

1978 Schultz Drilling Co

Washington

date well completed

firm name

county well located

LANDOWNER: Harvey Marshall
Hollandale MS

description of formations encountered

from

to

(mailing address)

Clay 0 14
fine SAND 14 50
COARSE SAND 50 70

WELL LOCATION:

sec. 4 T. 15 N. R. 6 E
S
miles E of Hollandale
(distance) (direction) (nearest town)

WELL PURPOSE: Domestic
(home, irrigation, municipal, industrial)

WELL COMPLETION DATA:

(1) diameter (inches) 2 in
(2) total depth (feet) 70 ft
(3) static water level (feet) 16 below above
top of ground.

(4) casing PVC 65 ft
(material) (depth)

(size) if telescope see back.

(5) screen 5 ft 65
(length) (depth to top)

2 in PVC
(size) (material)

(6) pump _____ (HP) _____ (yield gpm)

(type power)

(7) electric log NO
(yes or no)

(organization running log)

(8) how well bottom plugged plug

DRILLERS REMARKS:


RECEIVED

JUN 12 1978

MISS. Bd. OF WATER COMM.

If well telescopes please sketch and show depths.

GROUND LEVEL

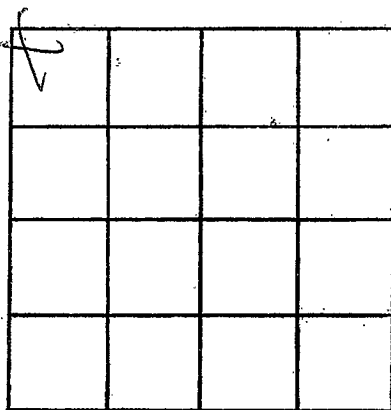

SECTION 4

Please indicate well location X.

ADDITIONAL INFORMATION

If more than one screen, show locations of each on sketch.