

WASHINGTON

P 2008

5-24-79

MISSISSIPPI BOARD OF WATER COMMISSIONERS
416 North State Street
Jackson, Mississippi 39201

WATER WELL DRILLERS LOG

5-24-79
date well completed

Schultz Drilling Co
firm name

Washington
county well located

LANDOWNER: R. Eipling

Hollandale

(mailing address)

WELL LOCATION:

sec 5-T-15-N

R-4-E

W

1 miles east of Hollandale
(distance) (direction) (nearest town)

WELL PURPOSE: home
(home, irrigation, municipal, industrial)

WELL COMPLETION DATA:

- (1) diameter (inches) 4x2
- (2) total depth (feet) 360
- (3) static water level (feet) 21 below top of ground

(4) casing PVC, 340
(material) (depth)

(size) if telescope see back.

(5) screen 20', 340
(length) (depth to top)

2" PVC
(size) (material)

(6) pump 1, 19
(HP) (yield gpm)

electric
(type power)

(7) electric log no
(yes or no)

(organization running log)

(8) how well bottom plugged n/w

description of formations encountered

from to

clay	0	60
sand	60	137
clay	137	320
sand-fine	320	340
Good sand	340	360

DRILLERS REMARKS:



Miss. Board of Water Commis

JUN 31 1979

RECEIVED

If well telescopes please sketch and show depths.

GROUND LEVEL

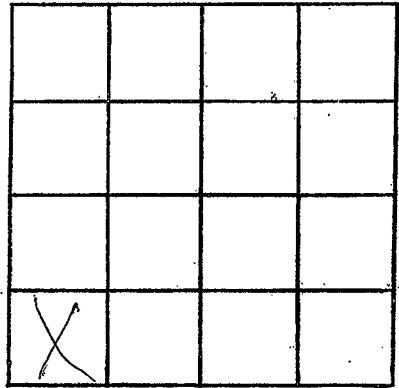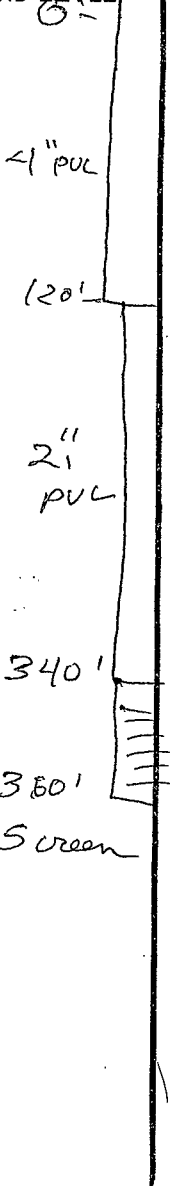

SECTION _____

Please indicate well location X.

ADDITIONAL INFORMATION

A series of horizontal lines for writing additional information, starting below the "ADDITIONAL INFORMATION" header and extending to the bottom of the page.

If more than one screen, show locations of each on sketch.