

MISSISSIPPI DEPARTMENT OF NATURAL RESOURCES

Bureau of Land and Water Resources

Southport Mall

P.O. Box 10631


Jackson, Mississippi 39209

WATER WELL DRILLERS LOG

WASHINGTON  
 P 2009  
 12/1/80


1 Dec 1980 date well completed      50 Lambert Drilling firm name      Wash county well located

LANDOWNER:	description of formations encountered	from	to
Floyd Hodges Rt 2 Box 129 Hollandale, Miss. (mailing address)	mixed	0	15
WELL LOCATION: sec. 2 T. 15 N. R. 6 E 8 S W 4 miles E of Hollandale (distance) (direction) (nearest town)	sand	15	60
WELL PURPOSE: home (home, irrigation, municipal, industrial)	sand & gravel	60	85
WELL COMPLETION DATA: (1) diameter (inches) 2	clay blue	85	182
(2) total depth (feet) 385	clay st sand	182	215
(3) static water level (feet) 41 below above top of ground.	sand med.	215	312
(4) casing PVC, 875 (material) (depth)	sand conc.	312	385
2 (size) if telescope see back.			
(5) screen 10, 375-365 (length) (depth to top)			
2 PVC (size) (material)			
(6) pump 1, 9 (HP) (yield gpm)			
elect (type power)			
(7) electric log no (yes or no)			
(organization running log)			
(8) how well bottom plugged back press			
DRILLERS REMARKS:			

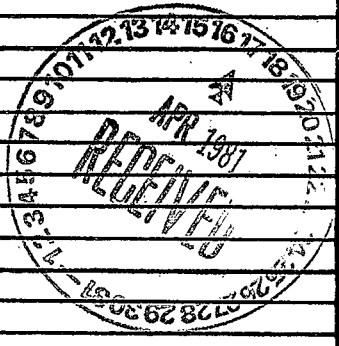

If well telescopes please sketch and show depths.

GROUND LEVEL

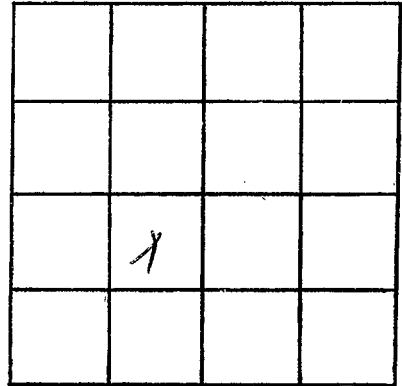

SECTION 2

Please indicate well location X.

ADDITIONAL INFORMATION

If more than one screen,  
show locations of each on sketch.