

Washington  
P 2010  
5-13-80

MISSISSIPPI  
BOARD OF WATER COMMISSIONERS  
416 North State Street  
Jackson, Mississippi 39201

WATER WELL DRILLERS LOG

April 2 19 80 Larry's Well & Pump Washington  
date well completed firm name county well located

LANDOWNER: E.P. Thomas  
Hollandale, Ms  
(mailing address)

WELL LOCATION:  
sec. 10 T 15 N R 6 E  
2 miles E of Hollandale  
(distance) (direction) (nearest town)

WELL PURPOSE: home  
(home, irrigation, municipal, industrial)

- WELL COMPLETION DATA:
- (1) diameter (inches) 4" x 2"
  - (2) total depth (feet) 900'
  - (3) static water level (feet) 23' <sup>below</sup> above top of ground.
  - (4) casing plastic 880'  
(material) (depth)
  - (size) if telescope see back.
  - (5) screen 40' 880'  
(length) (depth to top)
  - 2" plastic  
(size) (material)
  - (6) pump 2 40  
(HP) (yield gpm)
  - electric  
(type power)
  - (7) electric log No  
(yes or no)

(organization running log)

(8) how well bottom plugged  
wash plug

DRILLERS REMARKS:

description of formations encountered	from	to
clay	0'	20'
fine sand	20'	37'
med sand	37'	55'
coarse sand	55'	83'
coarse sand + sm gravel	83'	120'
clay	120'	220'
clay + sand	220'	350'
sand	350'	500'
sand + clay	500'	700'
clay	700'	770'
fine sand	770'	800'
clay	800'	850'
coarse sand	850'	900'


DEPT. OF NATURAL RESOURCES  
BUREAU OF LAND & WATER RESOURCES

MAY 12 1980

RECEIVED

If well telescopes please sketch and show depths.

GROUND LEVEL

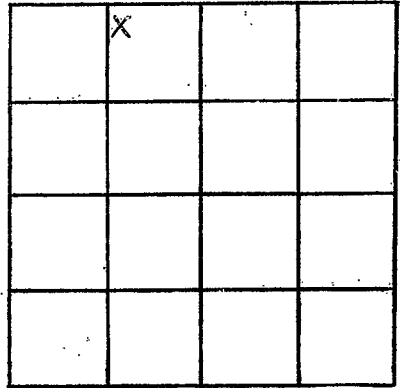

SECTION 60

Please indicate well location X.

ADDITIONAL INFORMATION

If more than one screen,  
show locations of each on sketch.