

MISSISSIPPI DEPARTMENT OF NATURAL RESOURCES

Bureau of Land and Water Resources

Southport Mall

P.O. Box 10631

Jackson, Mississippi 39209

WATER WELL DRILLERS LOG

WASHINGTON
 P
 202

12-10-1986
 date well completed

86 Schultz Drilling
 firm name

Washington
 county well located

LANDOWNER:	description of formations encountered	from	to
SYNERGY GAS Co. Hollandale MS (mailing address)			
WELL LOCATION:			
sec. <u>7</u> T <u>15</u> N R <u>76</u> E <u>1</u> miles <u>S</u> of <u>Hollandale</u> (distance) (direction) (nearest town)			
WELL PURPOSE: <u>INDUSTRIAL</u> (home, irrigation, municipal, industrial)			
WELL COMPLETION DATA:			
(1) diameter (inches) <u>2"</u>			
(2) total depth (feet) <u>90'</u>			
(3) static water level (feet) <u>26'</u> below top of ground.			
(4) casing <u>PVC</u> <u>80'</u> (material) (depth)			
_____ If telescope see back. (size)			
(5) screen <u>10'</u> <u>80'</u> (length) (depth to top) <u>2"</u> <u>PVC</u> (size) (material)			
(6) pump _____ <u>10</u> (HP) (yield gpm) <u>ele</u> (type power)			
(7) electric log <u>No</u> (yes or no) <u>D</u> (organization running log)			
(8) how well bottom plugged <u>CAP.</u>			

RECEIVED


FEB 06 1987

Department of Natural Resources
 Bureau of Land & Water Resources

DRILLERS REMARKS:

If well telescopes please
sketch and show depths.

GROUND LEVEL

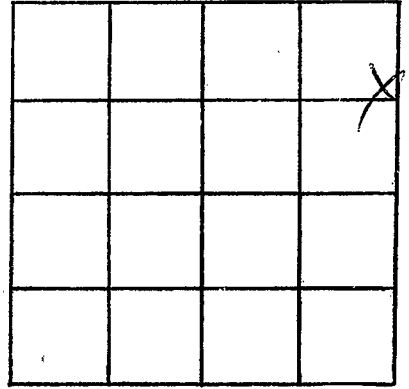

SECTION 7

Please indicate well location X.

ADDITIONAL INFORMATION

If more than one screen,
show locations of each on sketch.