

MISSISSIPPI DEPARTMENT OF NATURAL RESOURCES

Bureau of Land and Water Resources

Southport Mall

P.O. Box 10631

Jackson, Mississippi 39209

WATER WELL DRILLERS LOG

Washington  
P 2013

4-1-87, 19 date well completed

Schultz Drilling firm name

Washington county well located

LANDOWNER: GAINEE FARMS  
P. O. Box  
Hollandale MS  
(mailing address)

description of formations encountered

from

to

CLAY	0	39
SAND	39	100
SAND + GRAVEL	100	150
SHALE	150	400
SAND	400	482

WELL LOCATION:

sec. 17 T. 15 N. R. 6 E. W.

\_\_\_\_\_ miles (distance) \_\_\_\_\_ of (direction) \_\_\_\_\_ of (nearest town)

WELL PURPOSE: Home  
(home, irrigation, municipal, industrial)

WELL COMPLETION DATA:

- (1) diameter (inches) 4 1/2"
- (2) total depth (feet) 480'
- (3) static water level (feet) 37 below above top of ground.
- (4) casing PVC 460'  
(material) (depth)

\_\_\_\_\_ if telescope see back.  
(size)

- (5) screen 20' 460'  
(length) (depth to top)

2" PVC  
(size) (material)

- (6) pump 1 20  
(HP) (yield gpm)

elo  
(type power)

- (7) electric log NO  
(yes or no)

K  
(organization running log)

- (8) how well bottom plugged b/w


DRILLERS REMARKS:

**RECEIVED**

JUL 3 1987

Department of Natural Resources  
Bureau of Land & Water Resources

If well telescopes please sketch and show depths.

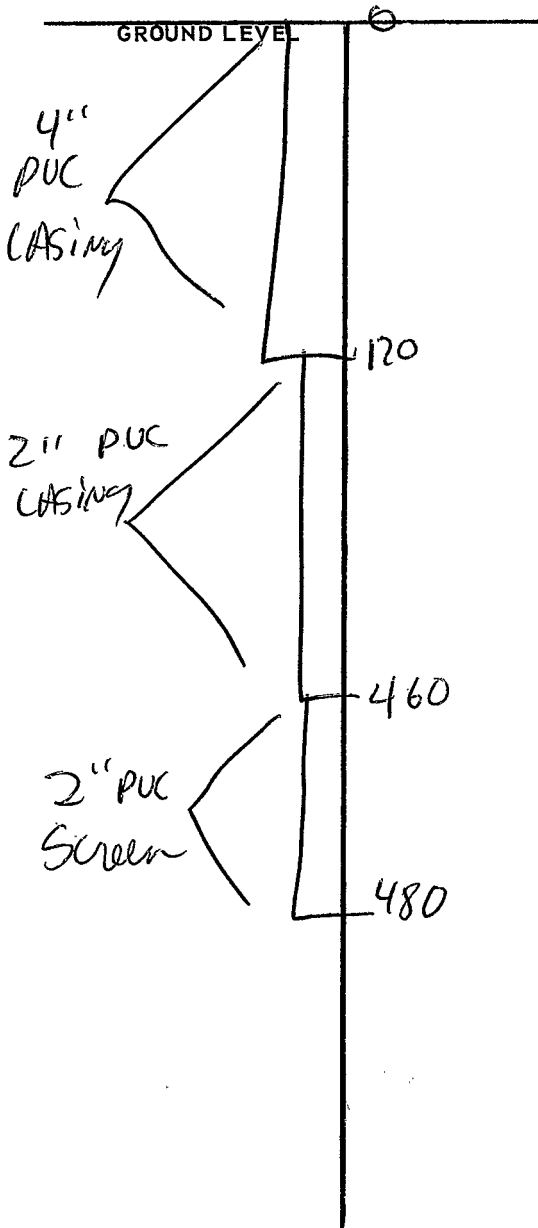

			<i>(Handwritten mark)</i>

SECTION 17

Please indicate well location X.

ADDITIONAL INFORMATION

If more than one screen, show locations of each on sketch.