

MISSISSIPPI DEPARTMENT OF NATURAL RESOURCES

Bureau of Land and Water Resources

COUNTY WELL LOCATED
Washington

WELL NUMBER
P

CODED

2014

DATE WELL COMPLETED
5-31-88

PERMIT NUMBER

NAME OF DRILLING FIRM
Seese's Pipe and Well

P.O. Box 10631
Jackson, Mississippi 39209
WATER WELL DRILLERS LOG

NAME & MAILING ADDRESS OF LANDOWNER
Tooney Woods & Sons

Box 427

Hollandale, Miss. 38748

WELL LOCATION: SEC 8 TOWNSHIP 15 RANGE 6

DISTANCE 1 Miles South of Hollandale

OTHER LANDMARK

WELL PURPOSE: Home, Irrigation, Municipal, Industrial, Fish Pond, etc.

PUMP DATA

PUMP TYPE (Circle One):
 Submersible Turbine, Jet Flowing Well,
Other (Describe)

POWER TYPE (Circle One):
 Electric, Tractor, Diesel, Gasoline, Butane,
Other (Describe)

Pump Capacity (GPM) <u>80</u>	No. of Stages <u>13</u>	Setting Depth <u>105</u> FT.
----------------------------------	----------------------------	---------------------------------

PUMP TEST

Well yielded 100 GPM with
a drawdown of 63 ft.
after 1.5 hours of pumping

WELL DATA

Well Depth <u>817'</u>	Casing Diameter (In.) <u>4" x 2"</u>	Casing Length (Ft.) <u>767'</u>
Type of Casing <u>P.V.C.</u>	Hole Depth <u>817'</u>	Depth to Static Water Level <u>35'</u>

TYPE OF COMPLETION: (Circle One or More):
 Gravel Packed, Underreamed, Telescoped,
 Natural Development, Open Hole, Other
(Describe)

Top of Lap Pipe or Reduction in Casing

FEET. IF TELESCOPED OR MORE THAN ONE SCREEN: USE BACK PAGE

LOG DATA

TYPE OF LOG RUN (Circle One): No Log Run, Electric, Gamma Ray, Density, Sonic, Neutron,
Other (Describe) Drillers

Name of Organization Running Log

SCREEN DATA

Diameter - Inches <u>2"</u>	Length - Feet <u>50'</u>	Slot Size - Inches <u>.010</u>
Screen Type <u>P.V.C.</u>	Depth to Bottom - Feet <u>767'-817'</u>	

GEOLOGIC DATA (Office Use Only)

Surface Elev.	Geologic Unit	Unit Thickness	Depth to Top
Subs. SWL	Date	Analysis	Acid Test

Driller's Remarks

FEB 02 1989

Department of Natural Resources
Bureau of Land & Water Resources

DESCRIPTION OF FORMATIONS ENCOUNTERED	FROM	TO	FORMATIONS (Continued)	FROM	TO
	0	20	"Fine" SAND	480	520
	20	158	CLAY	520	642
	158	200	Fine Sand	642	740
	200	203	Course Sand	740	817
	203	234			
	234	240			
	240	380			
	380	480			

IF MORE SPACE IS NEEDED, USE BACK

If well telescopes please sketch and show depths.

GROUND LEVEL

183'

4"

P.V.C.

584'


2" P.V.C.

50'

2" p.v.c. Screen

.010

If more than one screen,
show location of each on sketch.

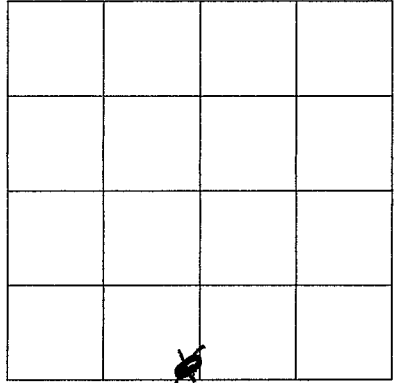

SECTION _____

Please indicate well location X.

ADDITIONAL INFORMATION

Multiple horizontal lines for additional information.